


T. 7 S. R. 5 W. W.M.

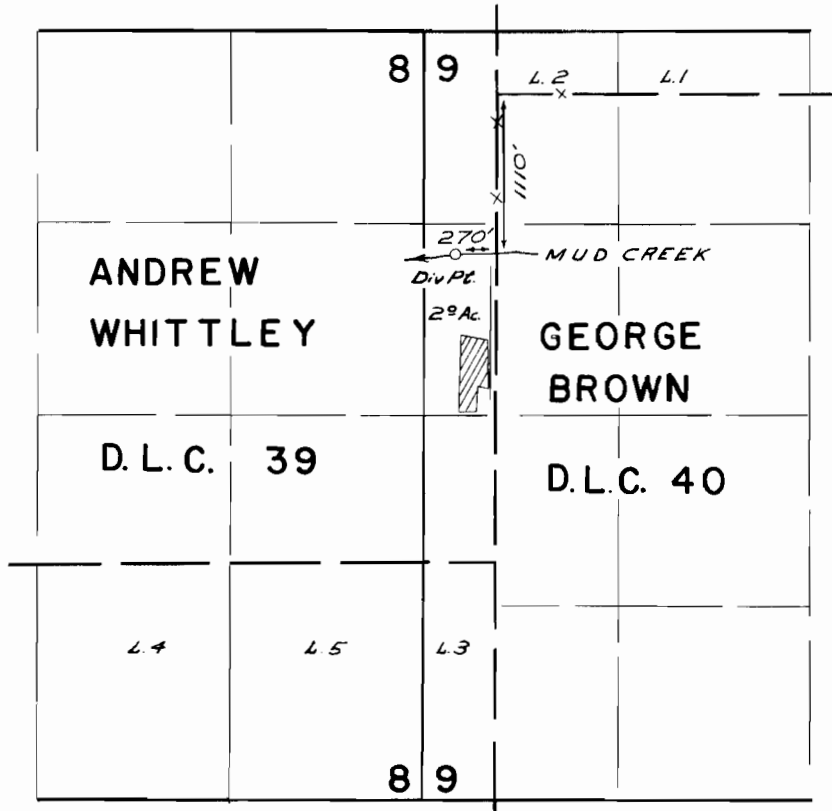

FINAL PROOF SURVEY
UNDER

Application No. 41130..... Permit No. 30663..
IN NAME OF

..... A. O. RUPP

Surveyed APR. 28 1966., by *W. J. Ruppert*
SEPT. 7 66