


T. 39 S. R. 7 W. W.M.

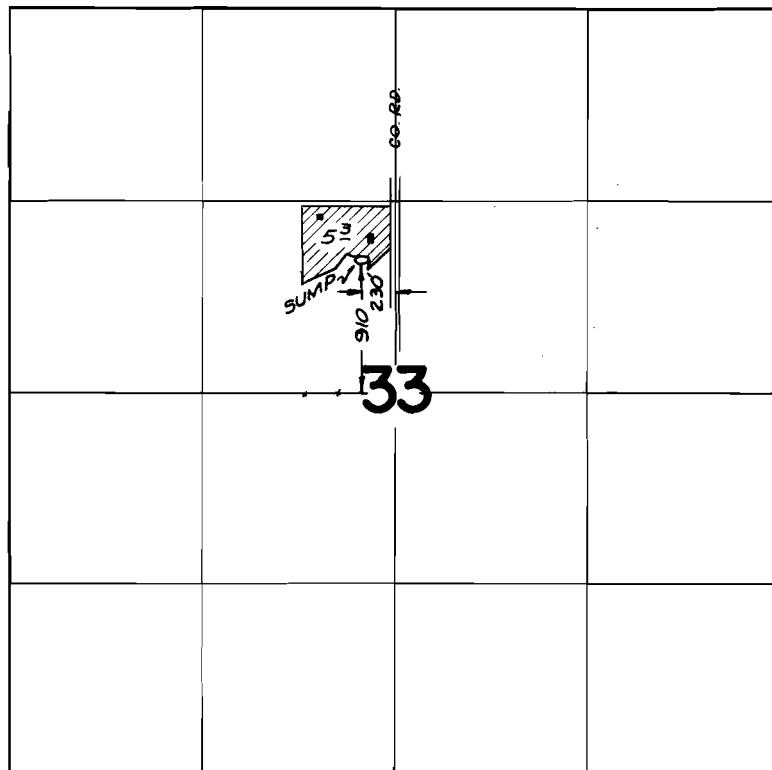

FINAL PROOF SURVEY
UNDER

Application No. G-2777 Permit No. G-2576
IN NAME OF

MARTIN H. MAURER

Surveyed May 17, 1967, by V. Garner