


T. 40 S. R. 9 W. W.M.

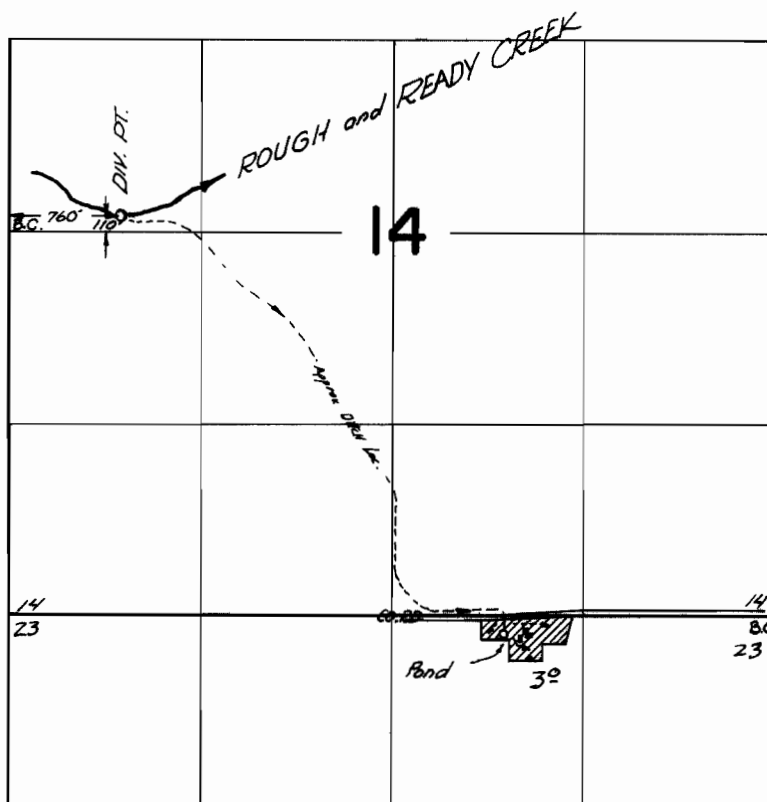

FINAL PROOF SURVEY
UNDER

Application No. 38165 Permit No. 28450
IN NAME OF

E. L. PHILLIPS and HAZEL GENTRY PHILLIPS

Surveyed May 19, 1967, by V. Garner