


T.6N.R.35E.W.M.

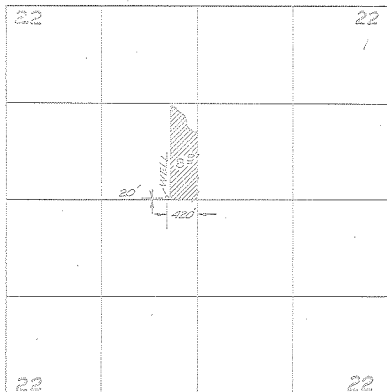

FINAL PROOF SURVEY  
UNDER

Application No. 6-2517 Permit No. 6-2323  
IN NAME OF

THOMAS FEHRENBACHER

Surveyed Oct. 26 1966, by M. GARNER