


T. 22 S. R. 31 & 32 E. W. M.



Well #7 located 5260 ft. N. & 1630 ft. W. from S.E. Cor. Sec. 36.
Well #18 located 4750 ft. N. & 3440 ft. W.

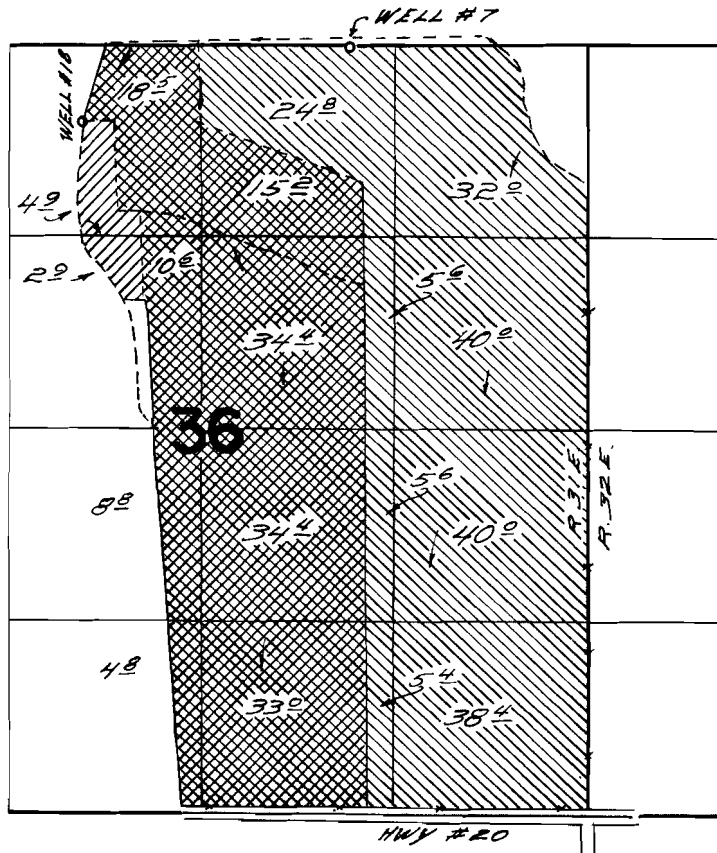

WELL #7



BOTH WELLS



WELL #18

FINAL PROOF SURVEY UNDER

Application No. G-1973 Permit No. G-1809
IN NAME OF

Harry Pom

Surveyed Sept. 20 1965, by C. Gardner