


T.5N.R.36E.W.M.

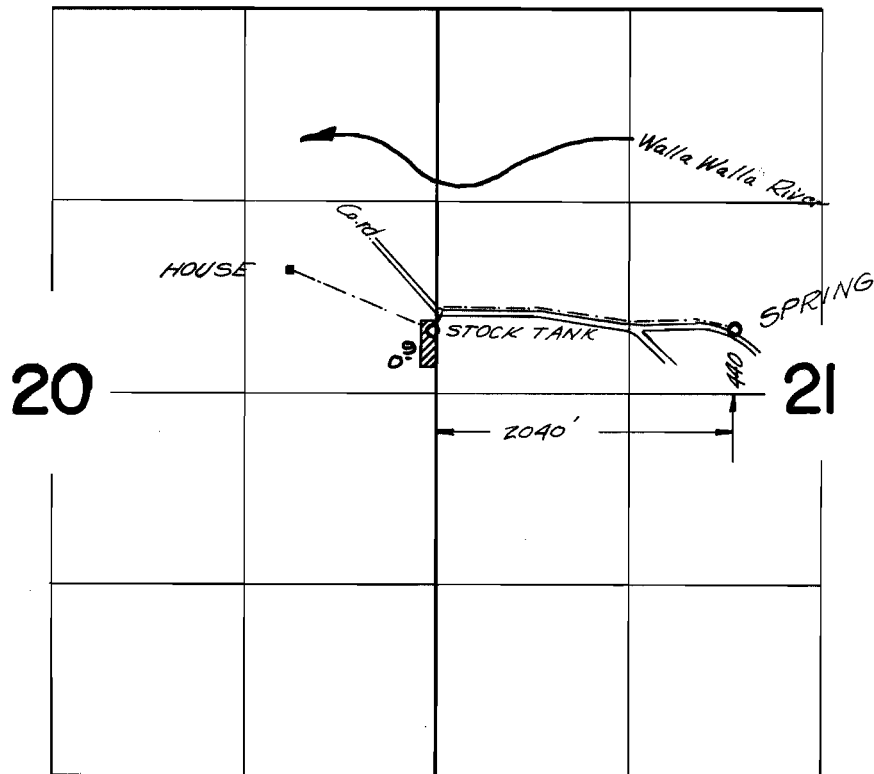

FINAL PROOF SURVEY
UNDER

Application No. 31690 Permit No. 26322
IN NAME OF

MABLE HARRIS

Surveyed Nov. 3, 1966, by V. GARNER

Permit # Corrected 8/16/99
NZ 4F 150