


T.4S.R.2&3W.W.M.

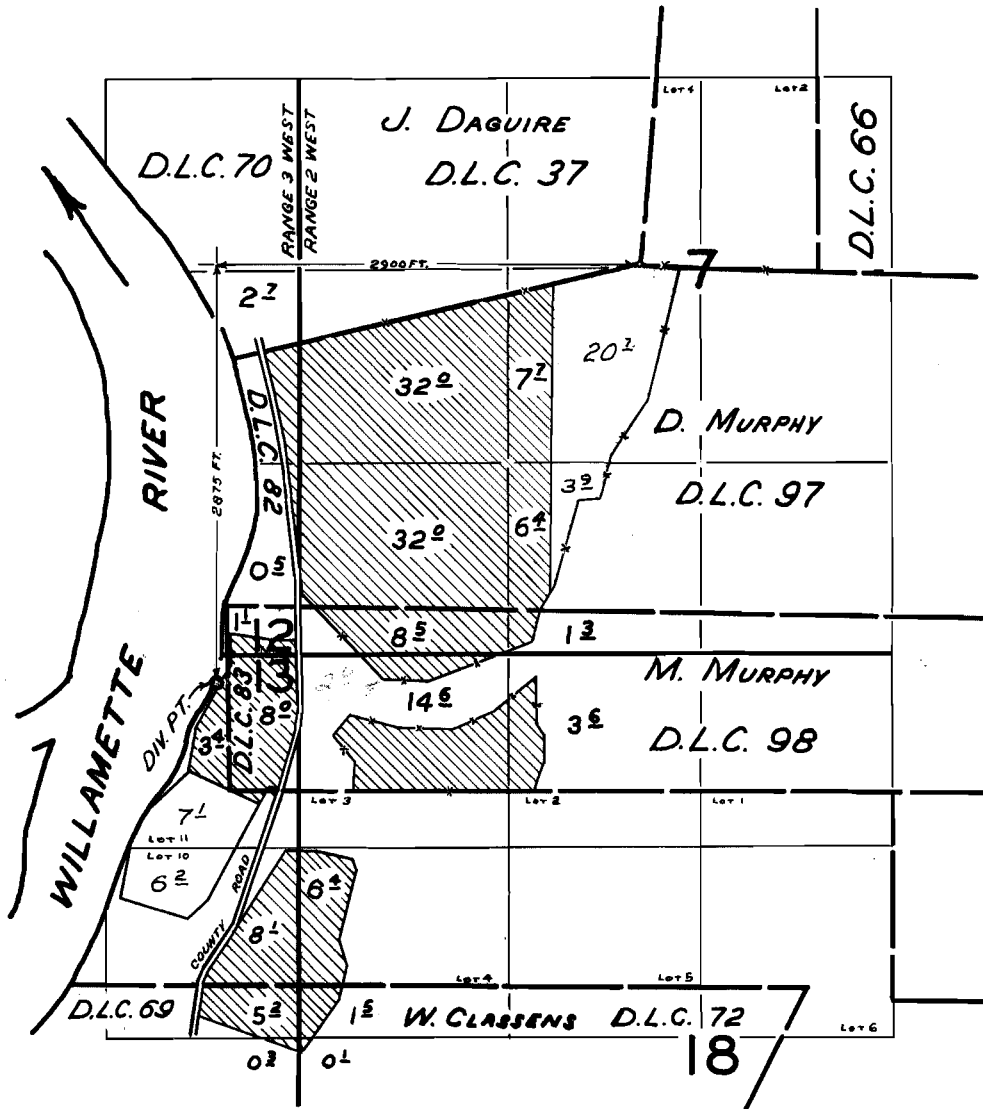

**FINAL PROOF SURVEY**  
UNDER

Application No. 40118 Permit No. 29979  
IN NAME OF

FRED B. HILLER

Surveyed APR. 23  
1 MAY 11 1965, by C. GARDNER