


T.2 N. R.5 W. W.M.

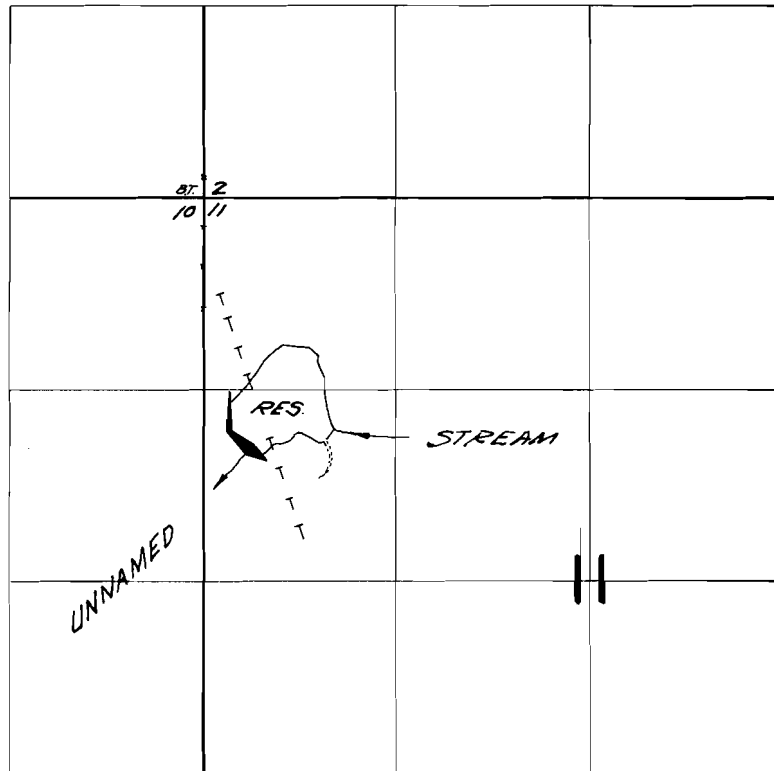

FINAL PROOF SURVEY
UNDER

Application No. R-38897 Permit No. R-3521
IN NAME OF

LEO L. BAUER

Surveyed June 7 1967, by V. Garner