


T. 1 N. R. 3 W. W.M.

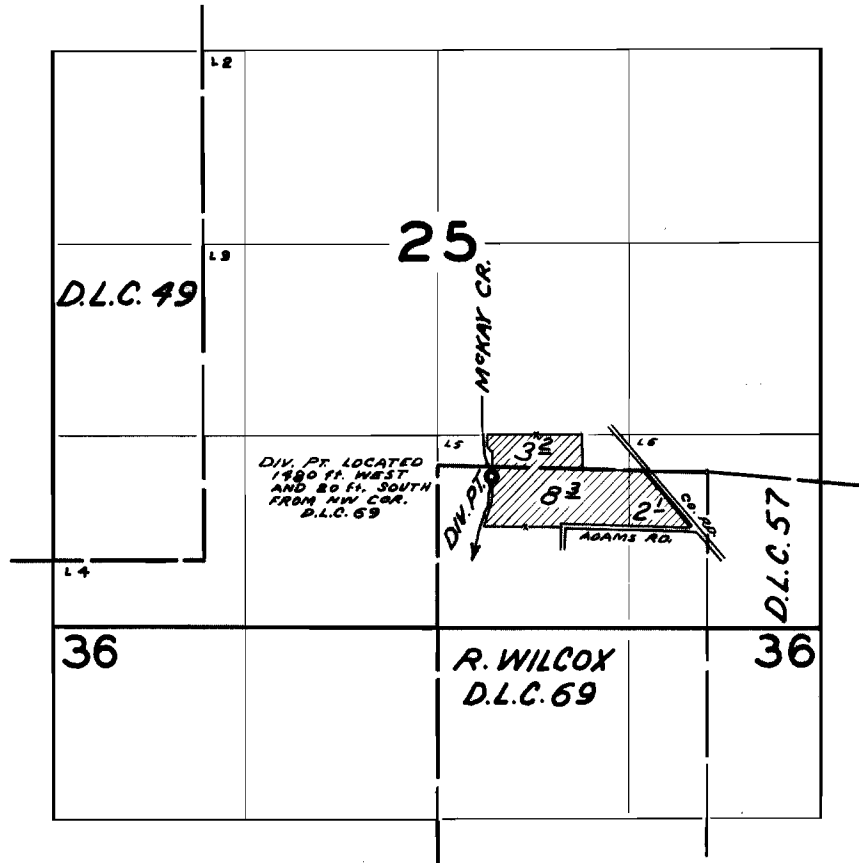

FINAL PROOF SURVEY UNDER

Application No. 33916 Permit No. 26747
IN NAME OF

LAVERN WILLIAM BUELT

Surveyed MAY 11 1967, by V. GARNER