


T. 1 S. R. 5 W. W. M.

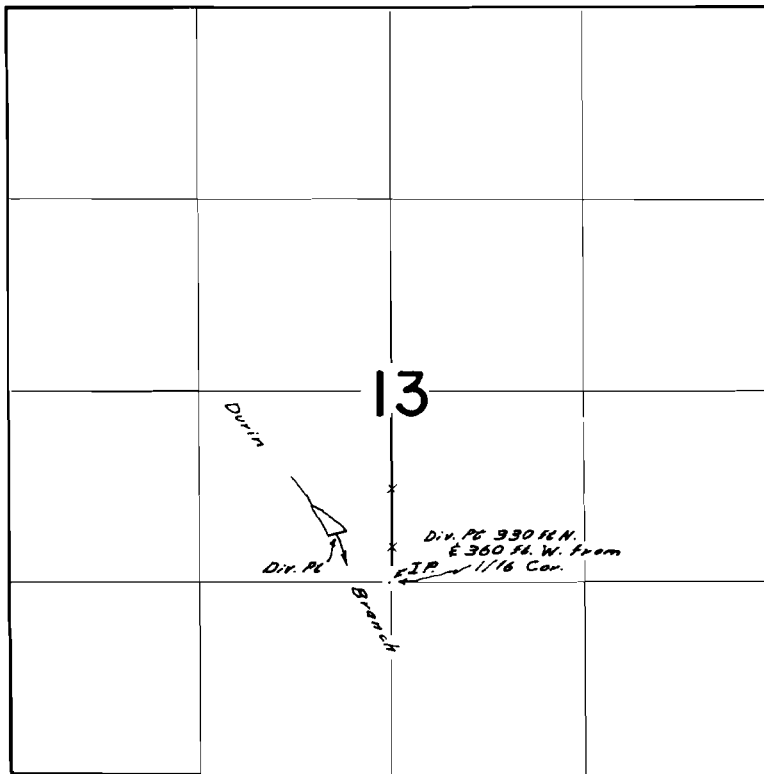

FINAL PROOF SURVEY UNDER

R-36799 *R-2694*
Application No. *36800* Permit No. *27640*
IN NAME OF

Herbert Hoodenpyl

Surveyed *Aug 23 1955*, by *W.J. Ruppert*