


T. 1 N. R. 1 W. W. M.

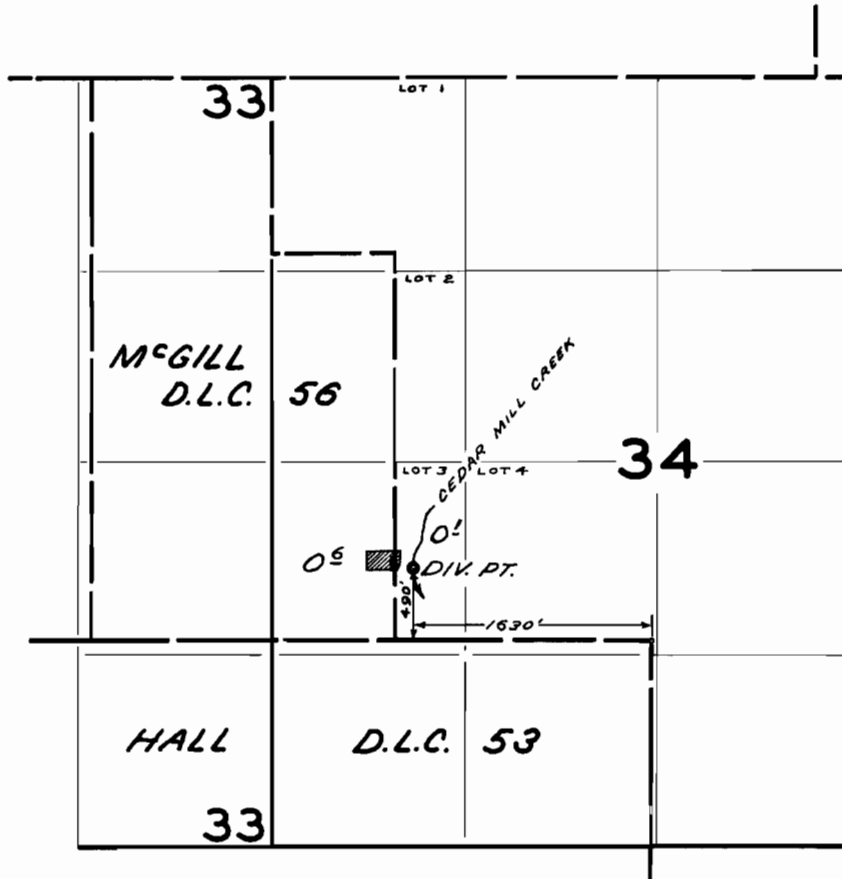

FINAL PROOF SURVEY
UNDER

Application No. 37404 Permit No. 27859
IN NAME OF

SAMUEL RALPH CHANEY

Surveyed SEP. 13 1967, by V. GARNER