


T.1N. R.3W. W.M.

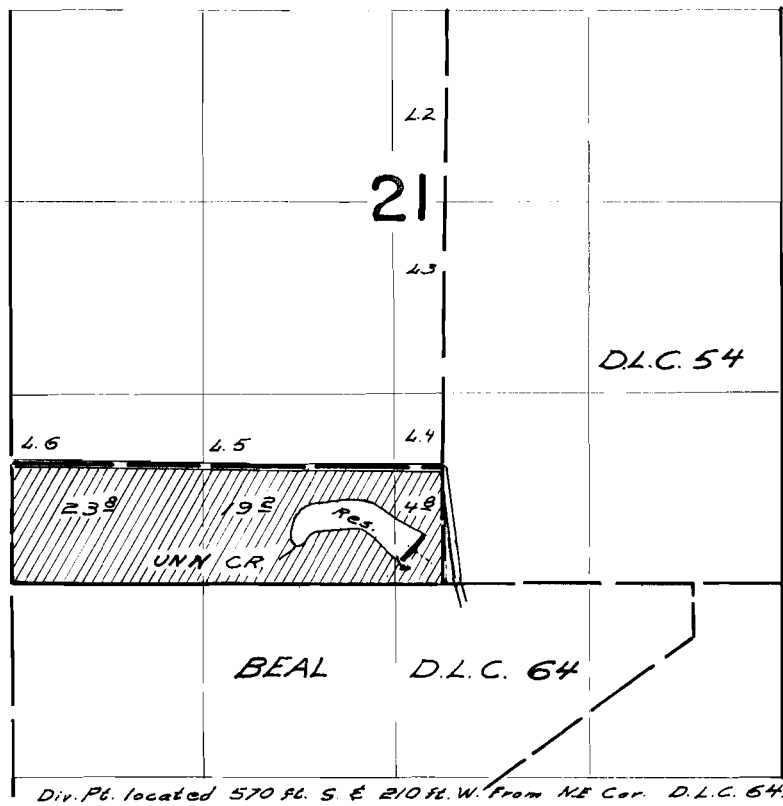

**FINAL PROOF SURVEY**  
UNDER

*R-38002 R-3143*  
Application No. *38003* Permit No. *28329*  
IN NAME OF

*Gene Lewis - Richard Peschka*

Surveyed *Aug 25* 1966, by *W.J. Ruppert*