


T. I. S. R. I. W. W. M.

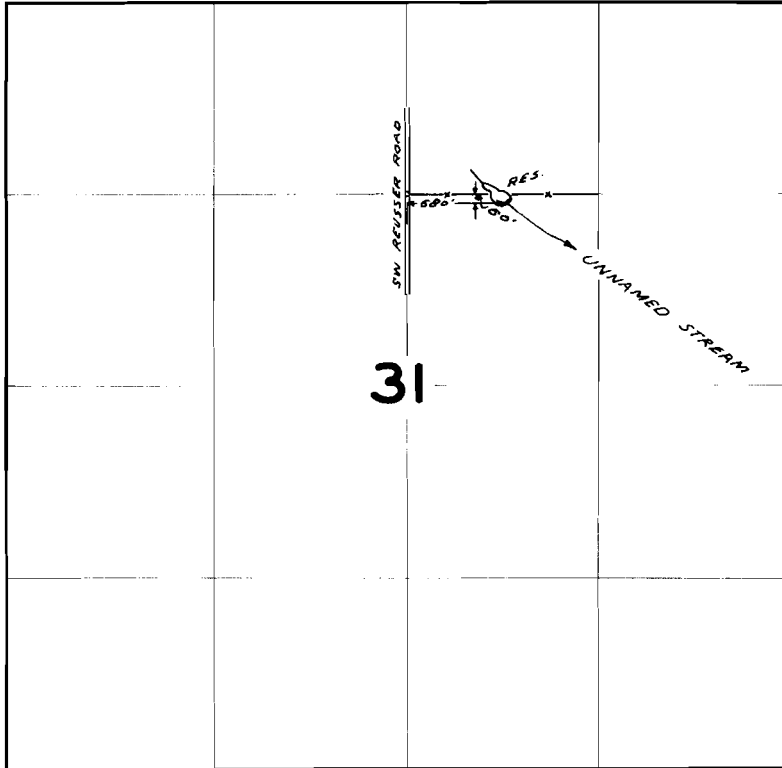

31

FINAL PROOF SURVEY UNDER

Application No. ^{R-91119} 42192 Permit No. ^{R-4688} 31114
IN NAME OF

EDNA HEARD

Surveyed *SEP 14* 19*67*, by *V. GARNER*