


# T. I. S. R. I. W. W. M.

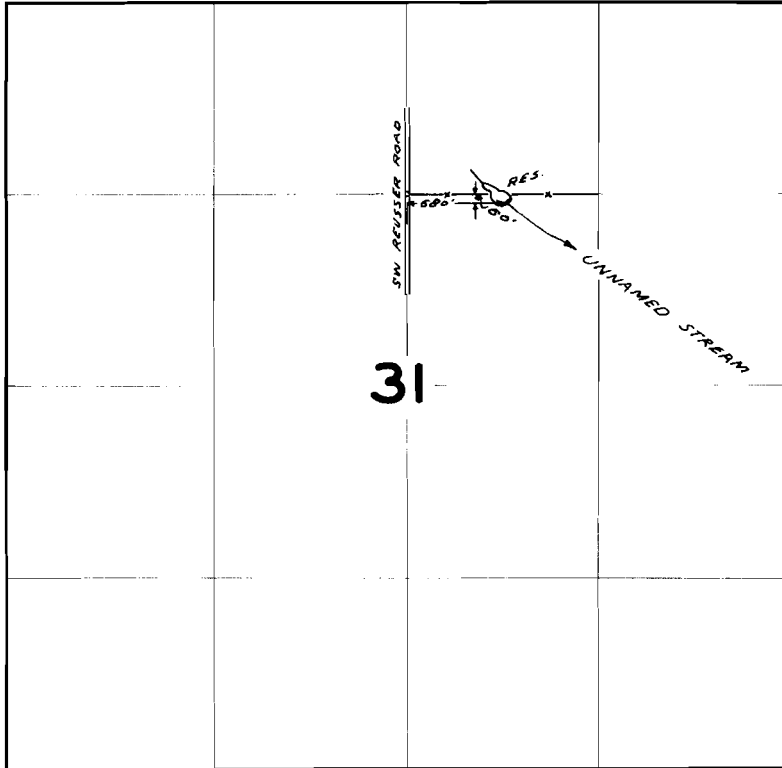

31

## FINAL PROOF SURVEY UNDER

Application No. <sup>R-91119</sup> 42192 Permit No. <sup>R-4688</sup> 31114  
IN NAME OF

*EDNA HEARD*

Surveyed *SEP 14* 19*67*, by *V. GARNER*