


T. 5 S. R 7 W. W. M.

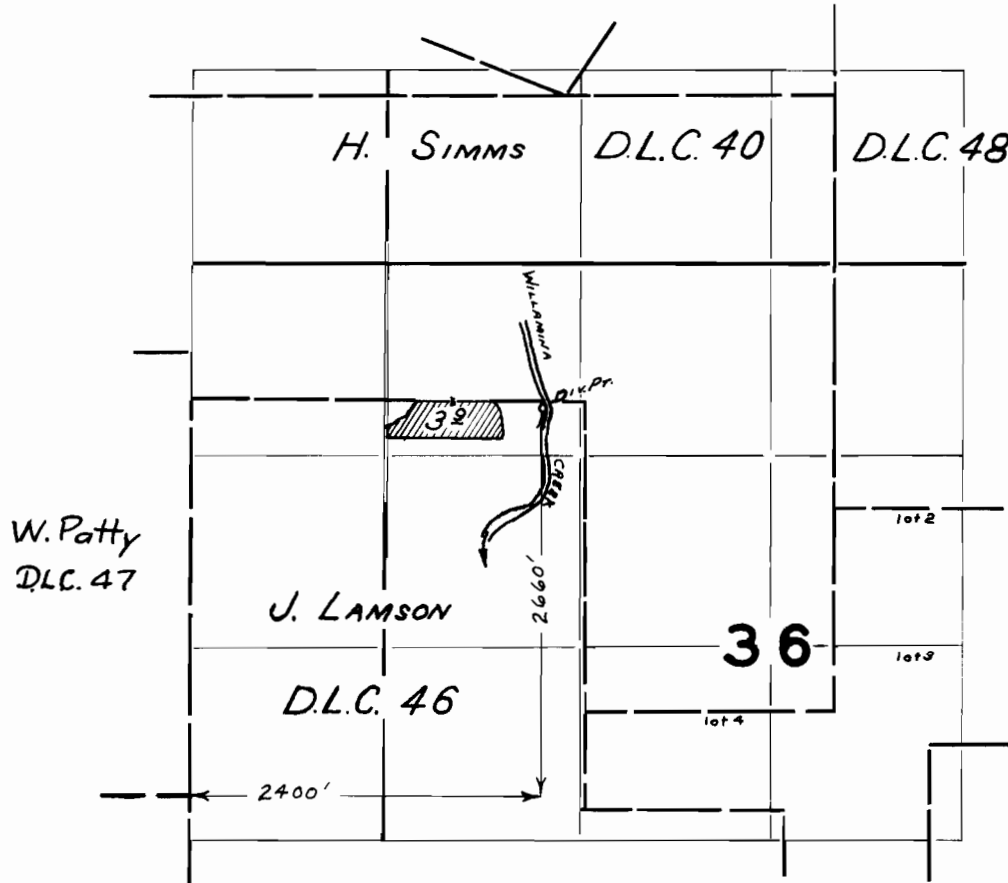

**FINAL PROOF SURVEY**  
UNDER

Application No. 34775 Permit No. 27297  
IN NAME OF

OPAL GARRETT LOUDON

Surveyed Ave 6 1964, by R. JACKSON