


T. 3 S. R. 4 W. W. M.

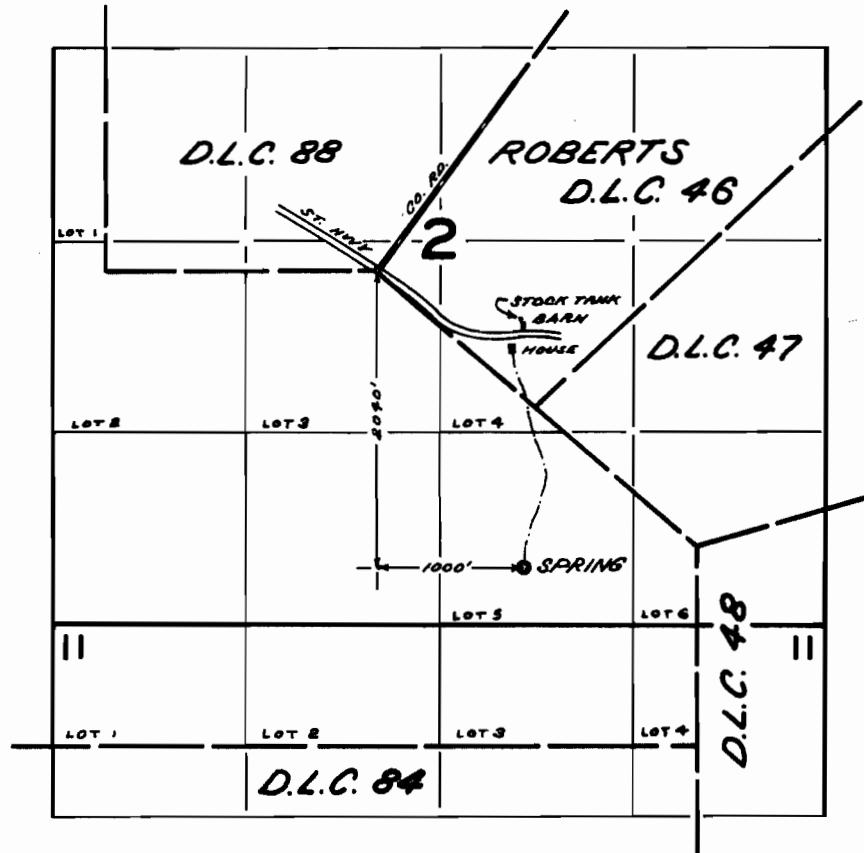

FINAL PROOF SURVEY
UNDER

Application No. 38948 Permit No. 29033
IN NAME OF

MARLON AKINS

Surveyed APR. 5 1967, by V. GARNER