


T.3S.R.5W.W.M.

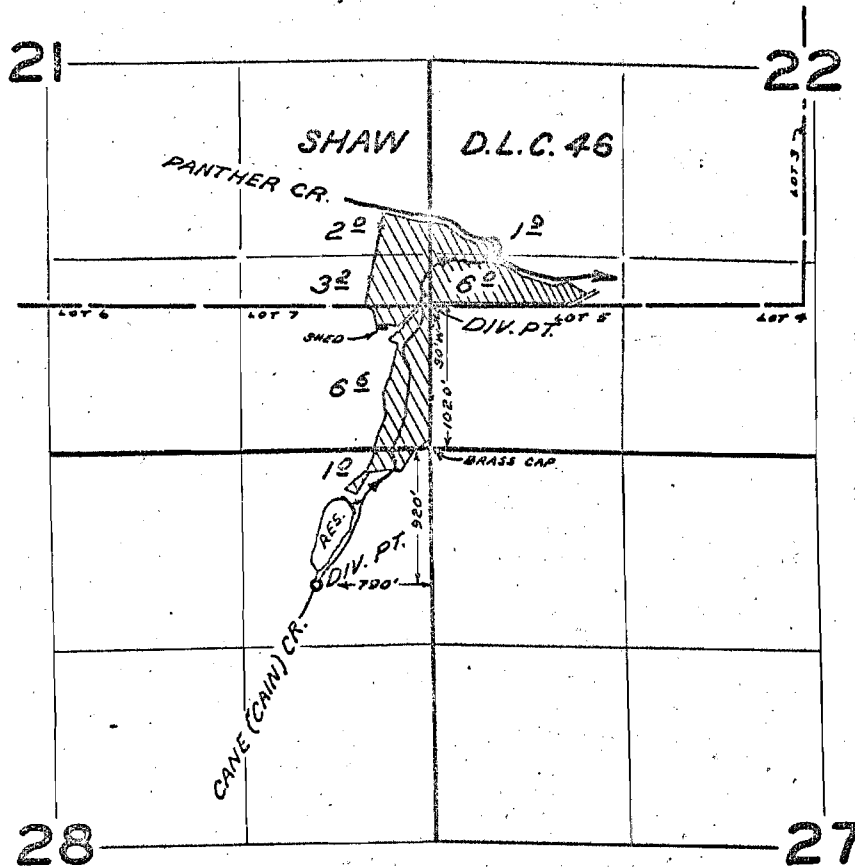

FINAL PROOF SURVEY
UNDER

Application No. R-39900 Permit No. R-4355
40262 29880
38004 28374
IN NAME OF

RICHARD N. VON

Surveyed MAY 2 1967, by V. GARNER