


T.5S.R.3W.W.M.

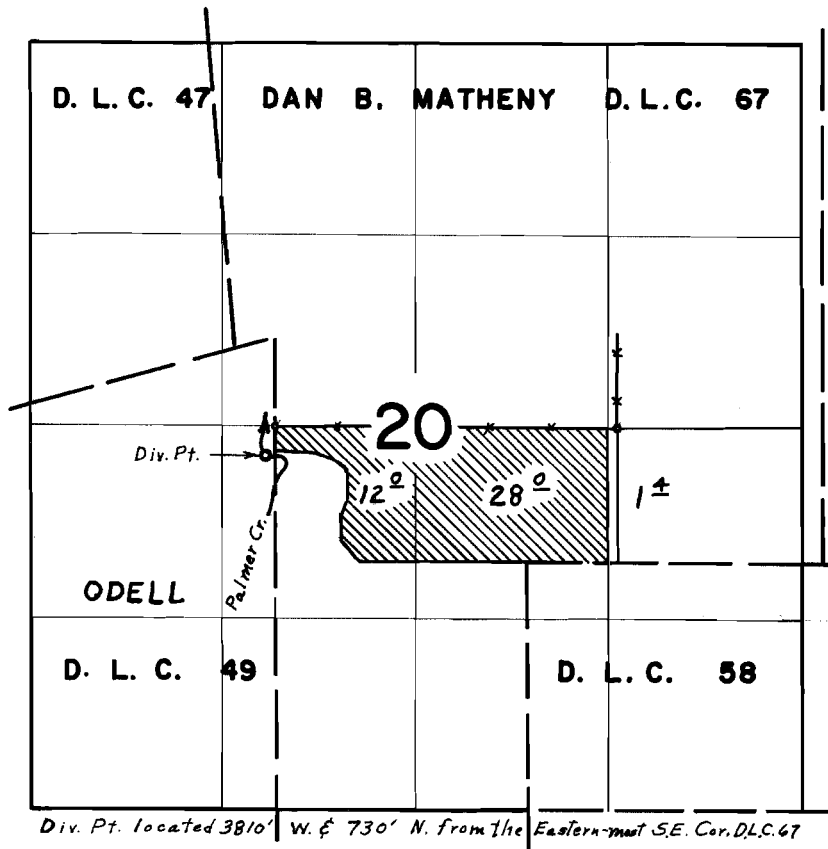

FINAL PROOF SURVEY UNDER

Application No. 40578 Permit No. 30233
IN NAME OF
JAMES C. SHELBURNE

Surveyed April 17, 1967, by L. E. Gould