


T.3S. R.3E.W.M.

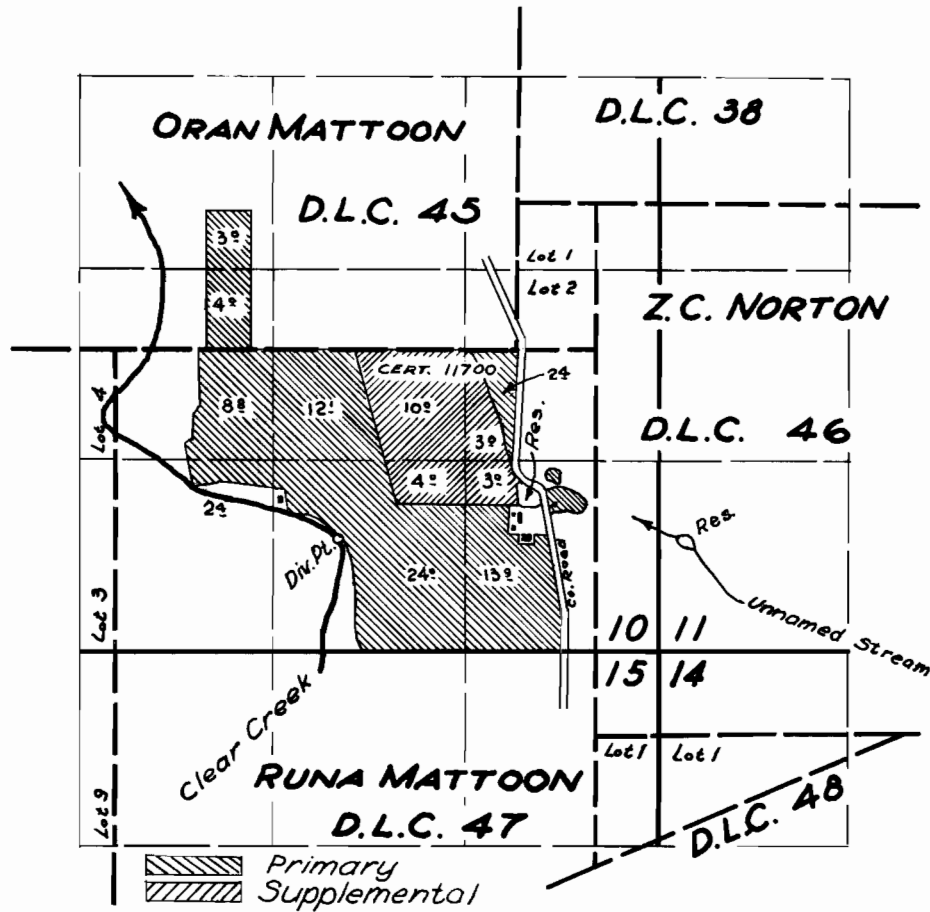

FINAL PROOF SURVEY
UNDER

Application No. 24455. Permit No. 20682
IN NAME OF

JOHN C. MCKENZIE

Surveyed 10 Oct. 1958, by C.Q. Bartels.