


T. 16 S. R. 4 W. W.M.

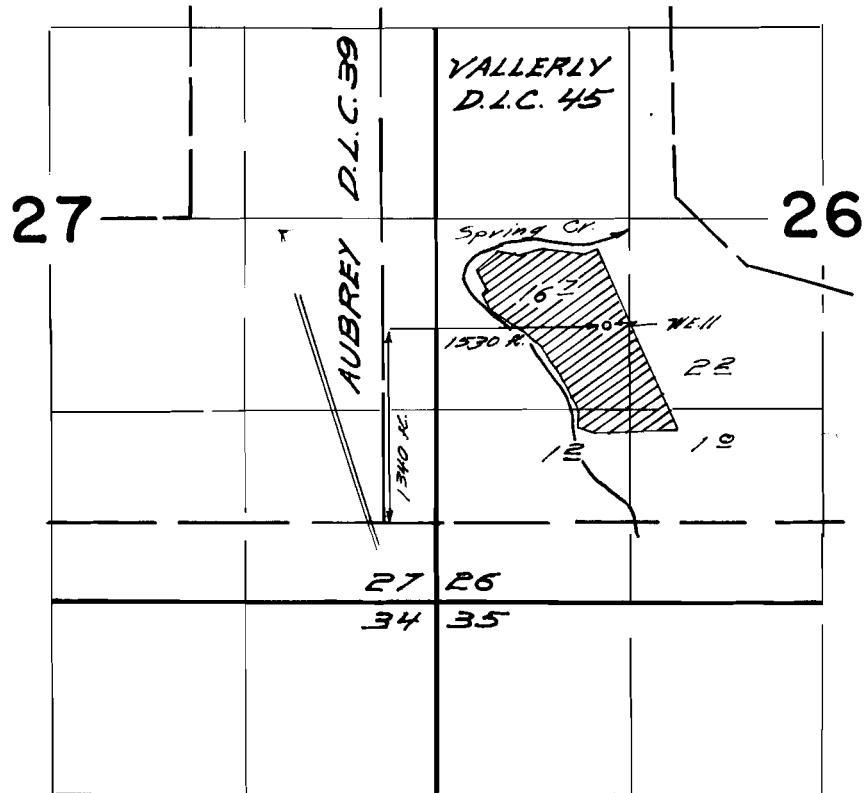

**FINAL PROOF SURVEY**  
UNDER

Application No. *G-2852* Permit No. *G-2655*  
IN NAME OF

*Clarence & Hazel Bond*

Surveyed *April 26 1965*, by *L. Colebank*.....