


# T.4S.R.2W.W.M.

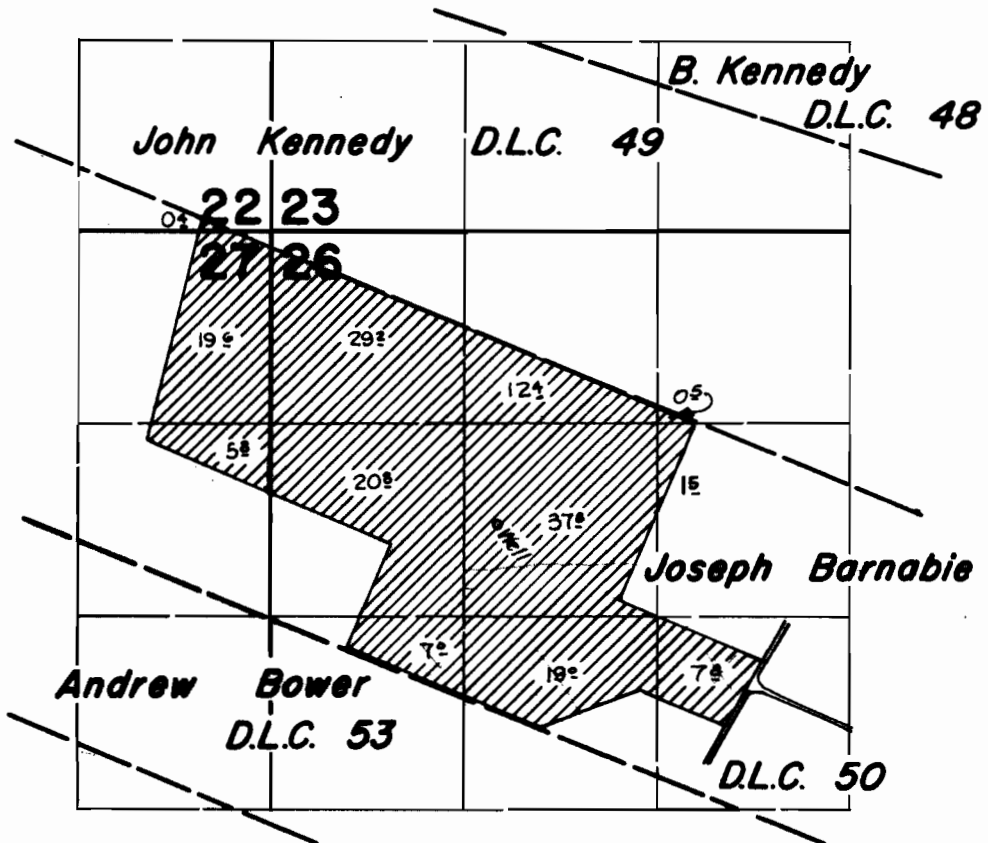

## FINAL PROOF SURVEY UNDER

Application No. G-963 Permit No. G-816  
IN NAME OF

CHAS. NEWTON DAVIS

Surveyed March 29 1962, by [Signature]