


T. 4S. R. 2 & 3 W. WM.

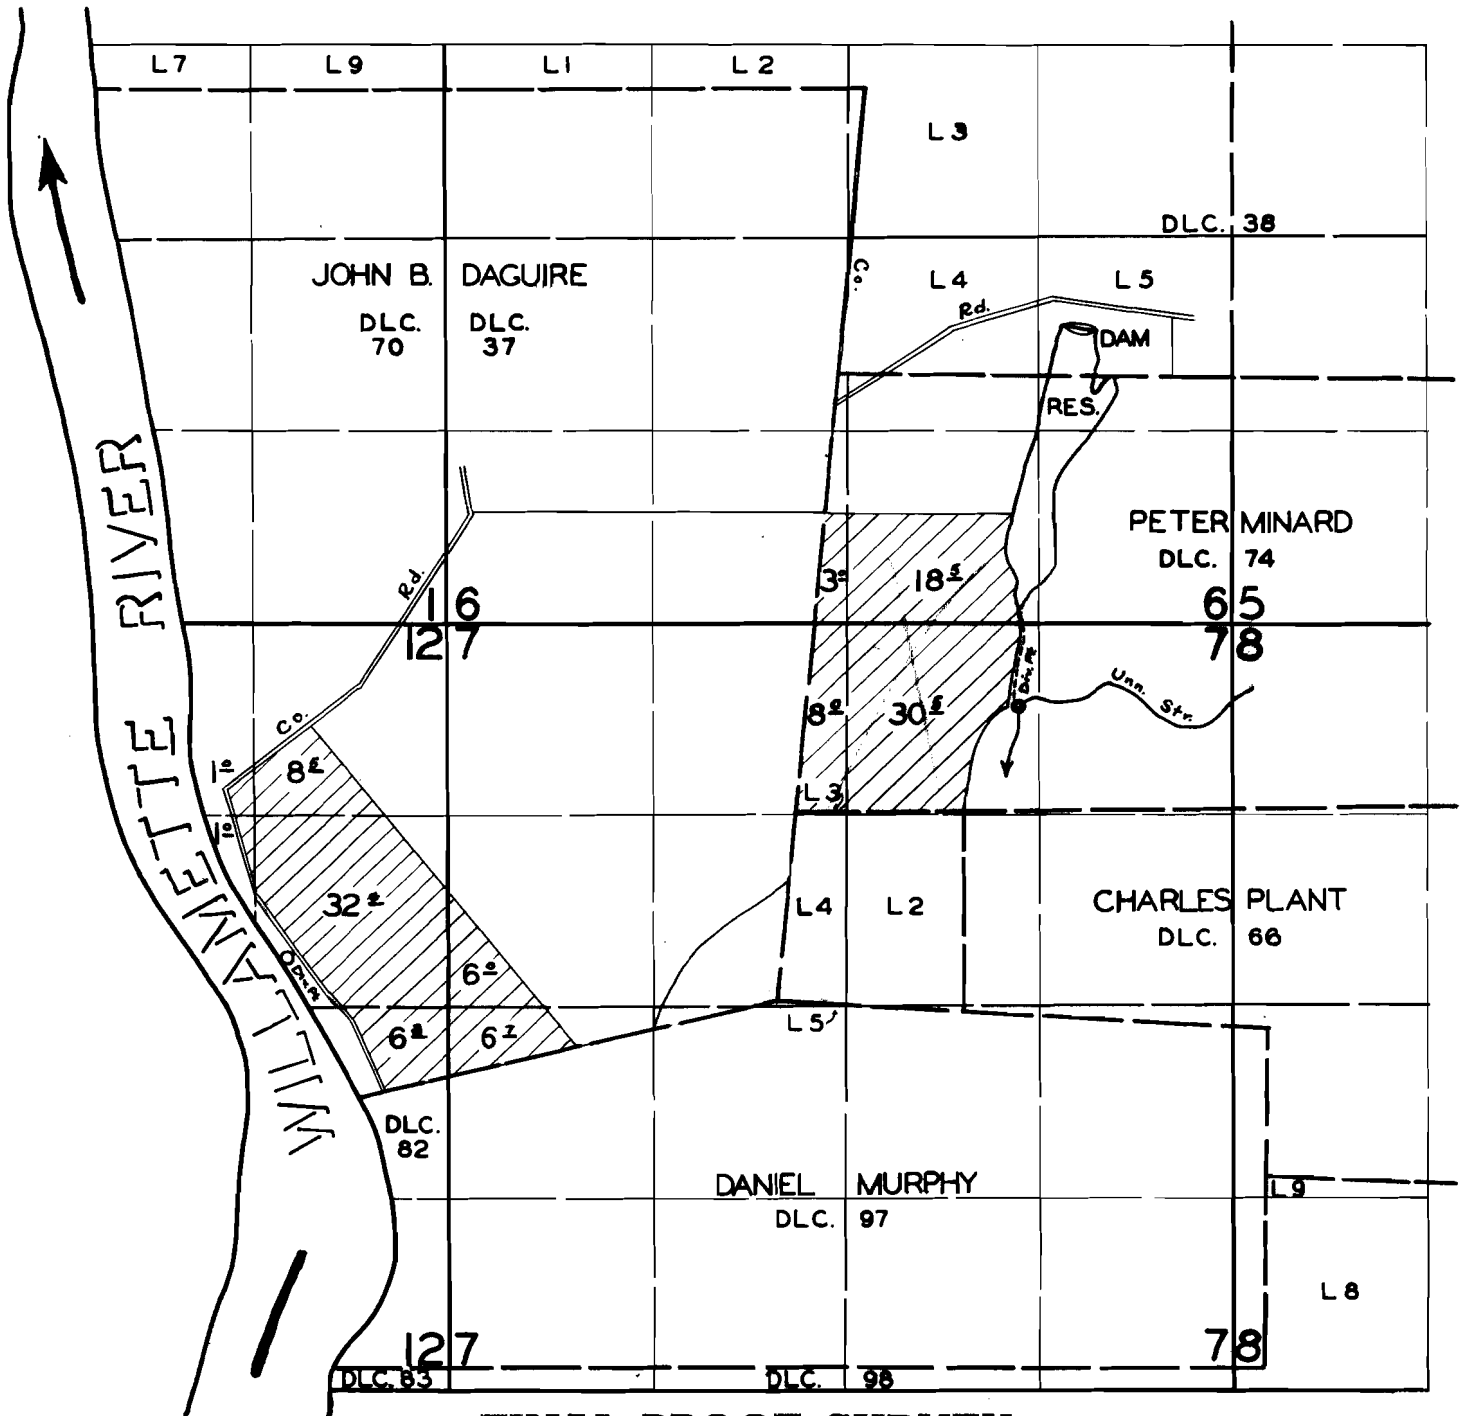

FINAL PROOF SURVEY

UNDER

Application No. 22014 Permit No. 19070

IN NAME OF

JOHN L. & CATHERINE ANN MARXER

Surveyed 2 MAR. 1956, by R.D. BEST

R.D.B.