


T.1N. R.3 W. W. M.

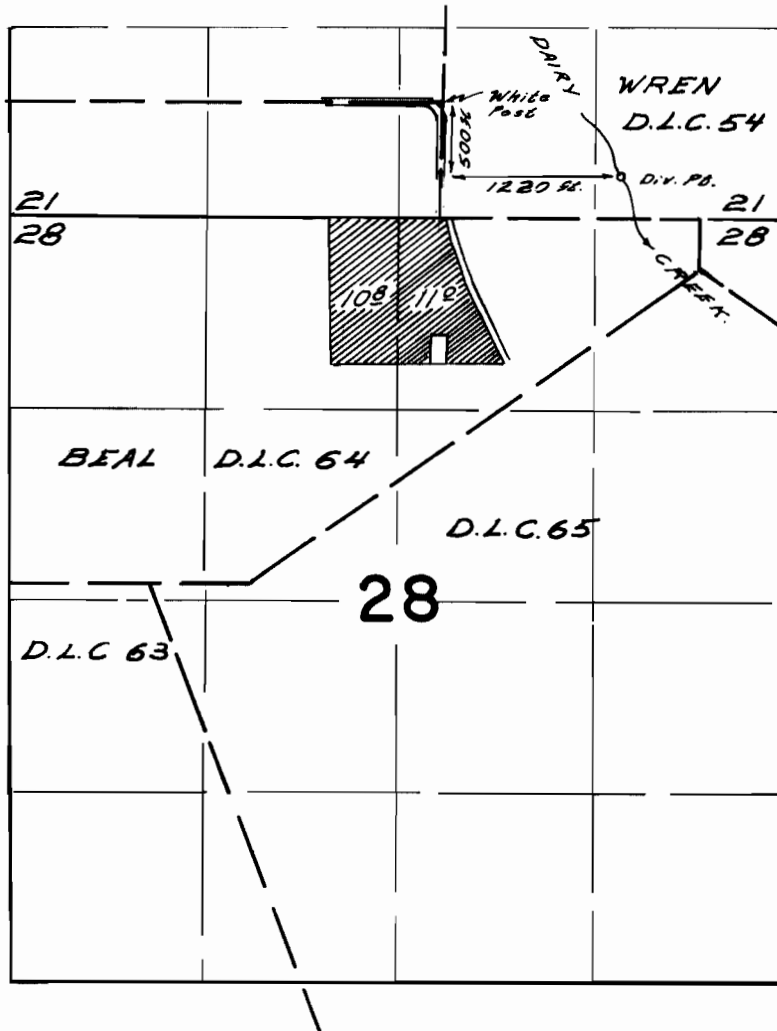

FINAL PROOF SURVEY UNDER

Application No. ~~38929~~ Permit No. 28971
IN NAME OF

Melvin Finegan

Surveyed *April 3, 1967*, by *W.D. Ruppert*