


T.3N.R.2W.W.M.

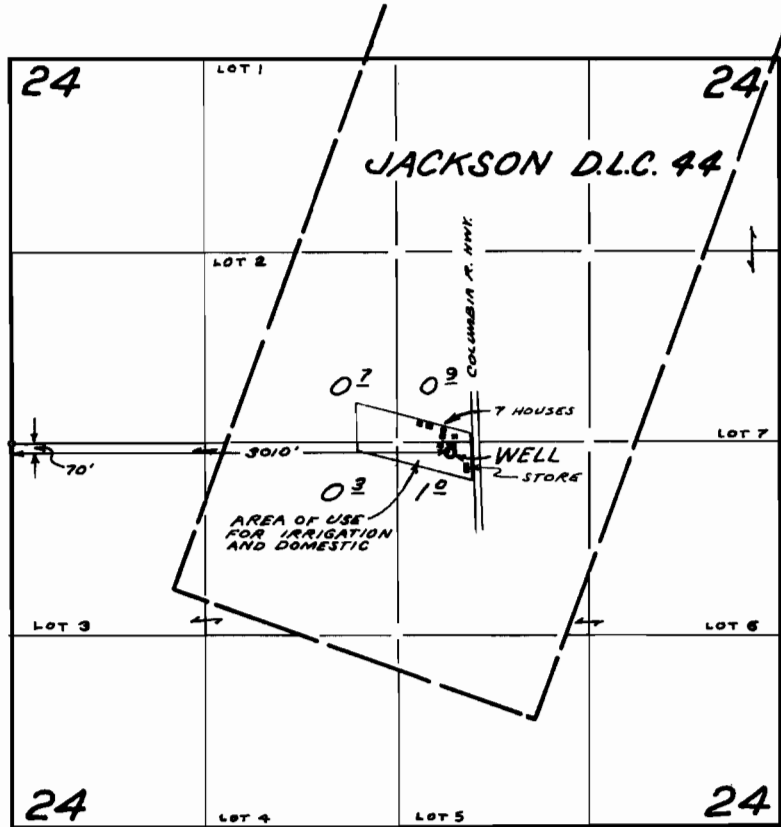

FINAL PROOF SURVEY UNDER

Application No. G-531 Permit No. G-521
IN NAME OF

ROY W. SAXTON

Surveyed JUL. 21, 1967, by V. GARNER