


T.6N. R.2W. W.M.

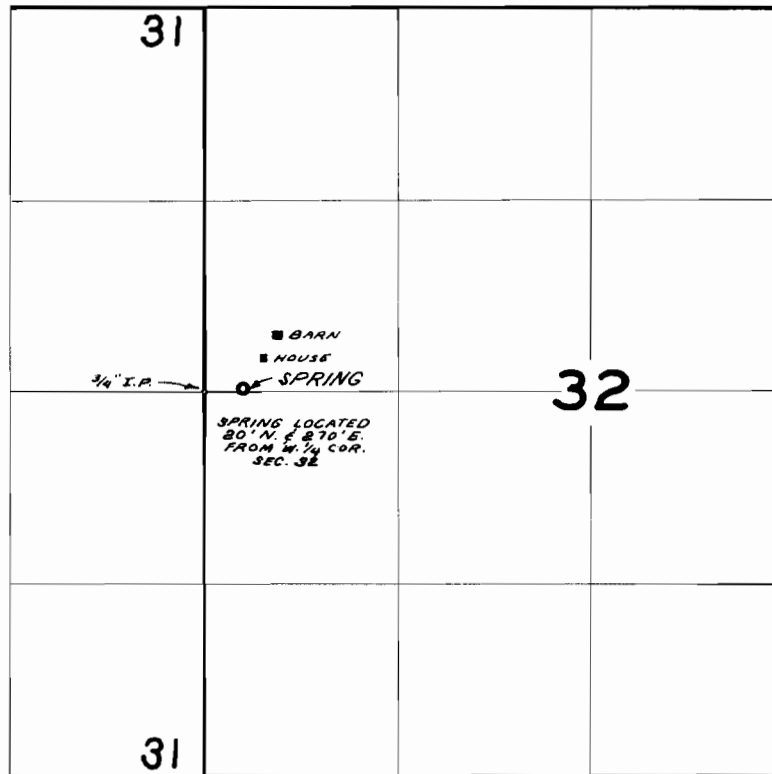

FINAL PROOF SURVEY
UNDER

Application No. 39584 Permit No. 29419
IN NAME OF

MRS. KATHRYN B. EKSTRAND

Surveyed JUL. 19. 1967, by V. GARNER