


T. 4 N. R. 3 W. W. M.

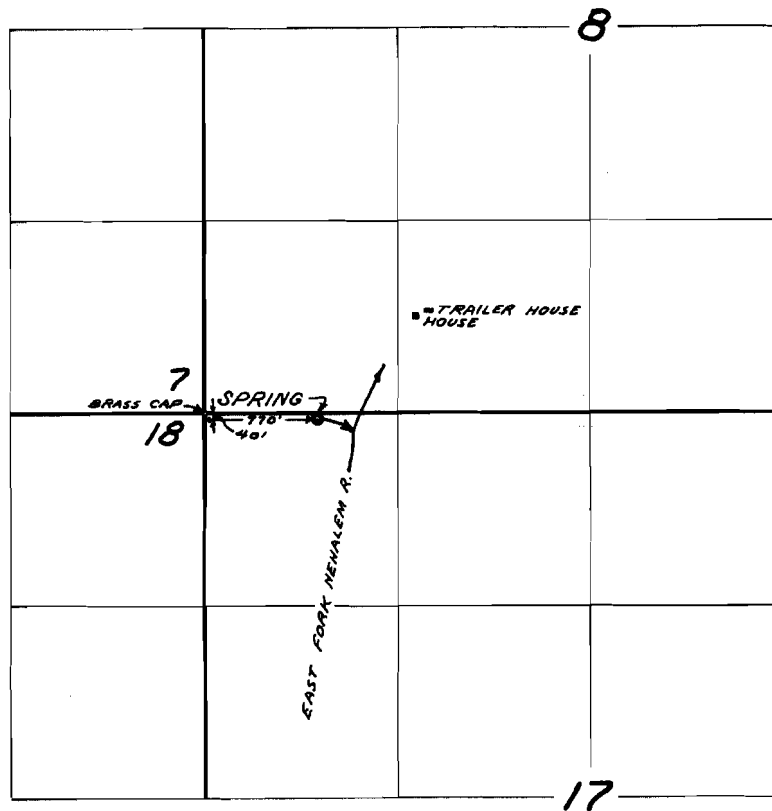

FINAL PROOF SURVEY
UNDER

Application No. 40041 Permit No. 29849
IN NAME OF

DANIEL E. KOCH

Surveyed AUG 17 1967, by V. GARNER