


T.31S. R.15 W. W.M.

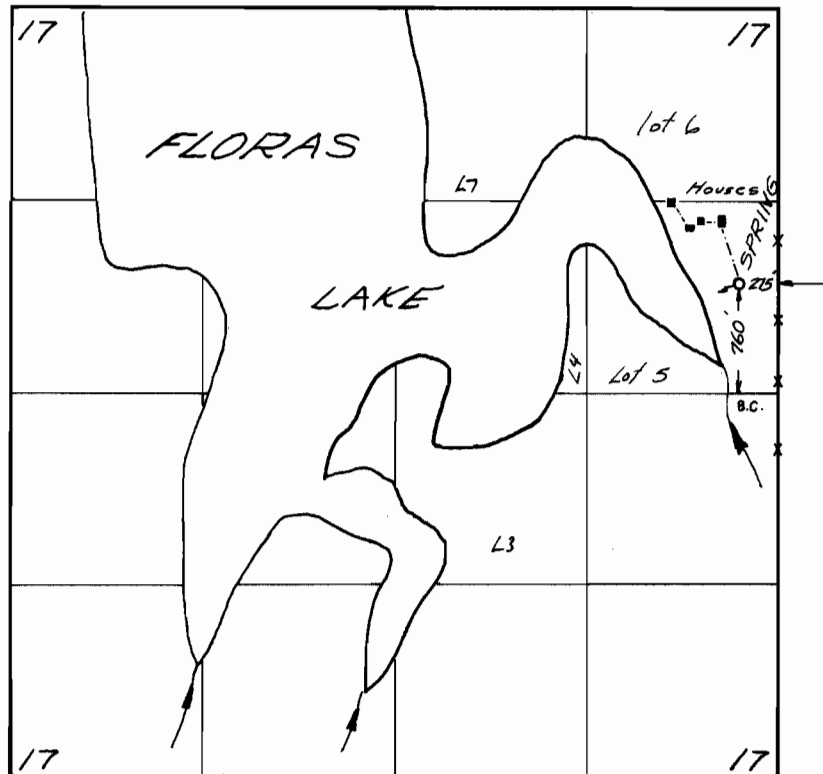

FINAL PROOF SURVEY
UNDER

Application No. 38714 Permit No. 28828
IN NAME OF

KENNETH C and LAURA ETHELEENE THOMPSON

Surveyed Sept 16 1966, by V. G. ARNER