


T.29 S. R.5 W. W.M.

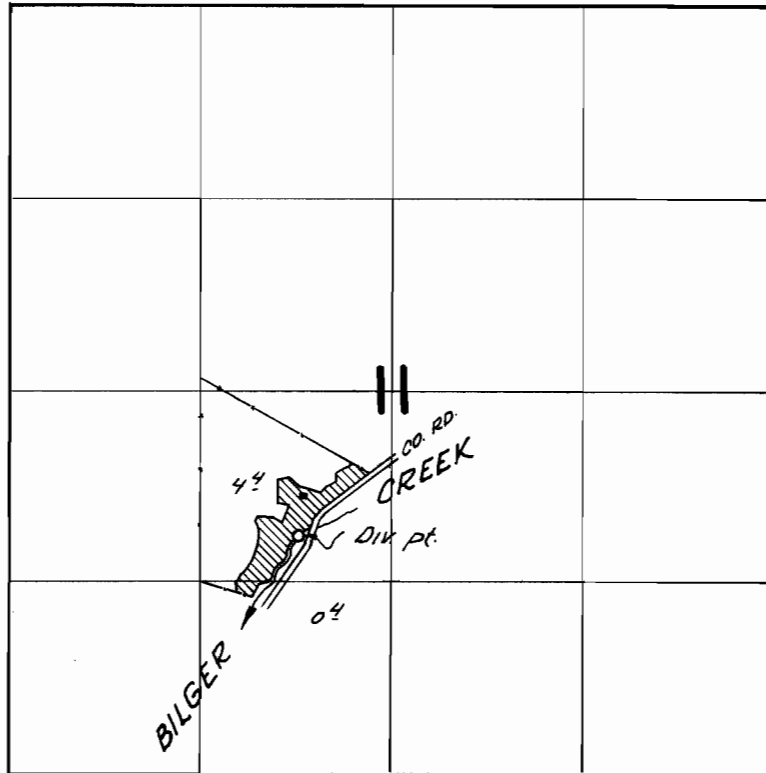

*Div. pt. located 310 ft. N. and 670 ft. E. from
the SW. cor. NE $\frac{1}{4}$ SW $\frac{1}{4}$, Sec. 11 (SW prop cor.)*

FINAL PROOF SURVEY
UNDER

Application No. 37024 Permit No. 27594
IN NAME OF

RICHARD L. ESTERBROOK

Surveyed Sept. 12 1962, by V. Gorman