


# T.29S.R.5W. W.M.

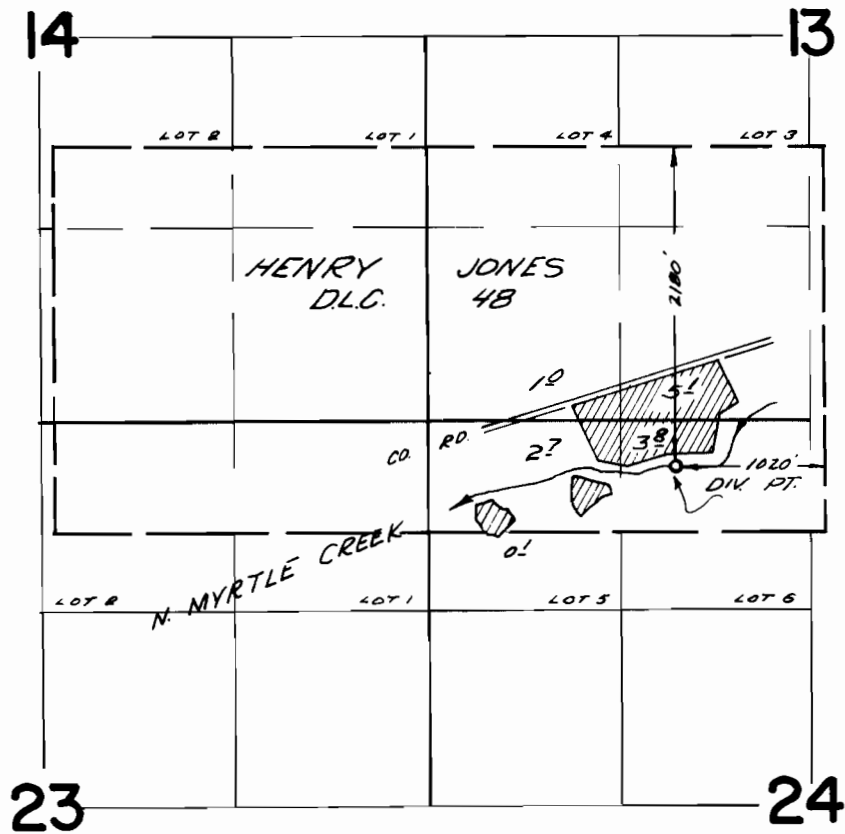

## FINAL PROOF SURVEY UNDER

Application No. 37441 Permit No. 27879  
IN NAME OF

VICTOR J. RICE

Surveyed Sept. 19, 1967, by V. Garner