


T.28S. R.6W. W.M.

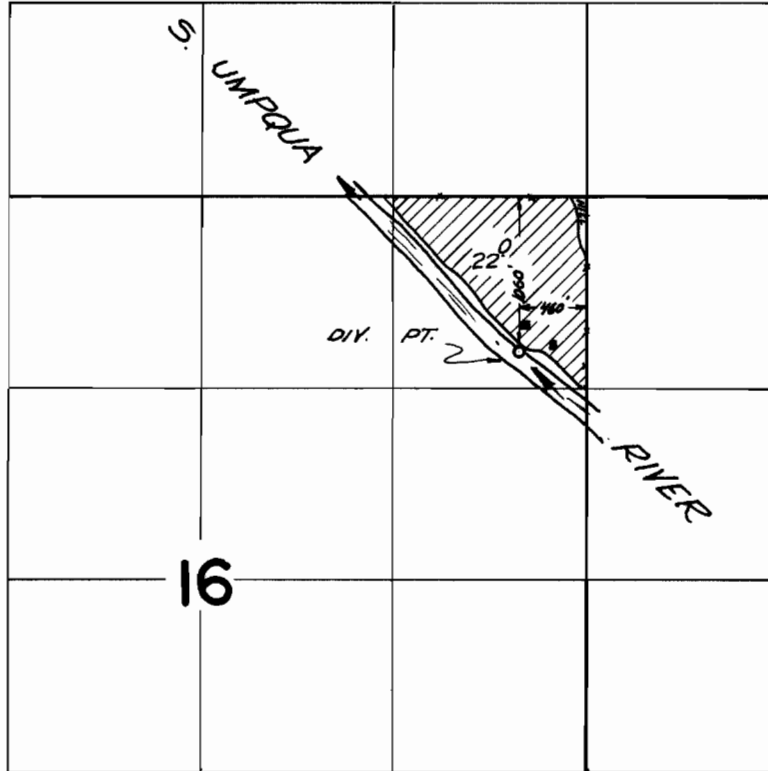

FINAL PROOF SURVEY UNDER

Application No. 38690 Permit No. 28784
IN NAME OF

FLOYD and JUNE EMMITT

Surveyed April 25, 1967, by V. Garner