


T.25 S. R.5 W. W.M.

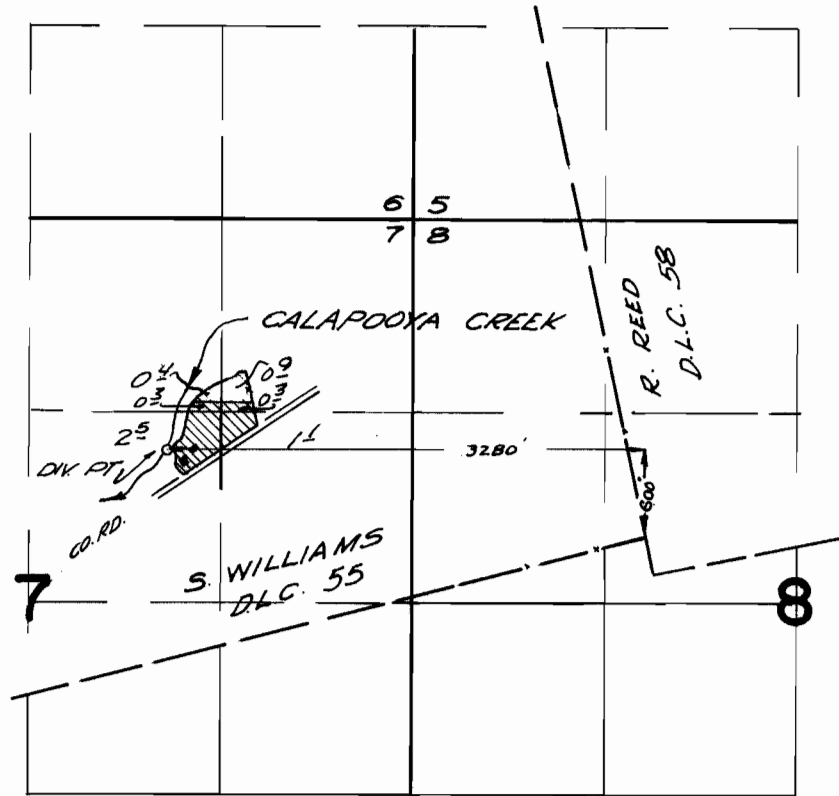

FINAL PROOF SURVEY UNDER

Application No. 38616 Permit No. 28811
IN NAME OF

HENRY L. KASAL

Surveyed April 27, 1967, by V. Garner