


T.28S.R.6W. W.M.

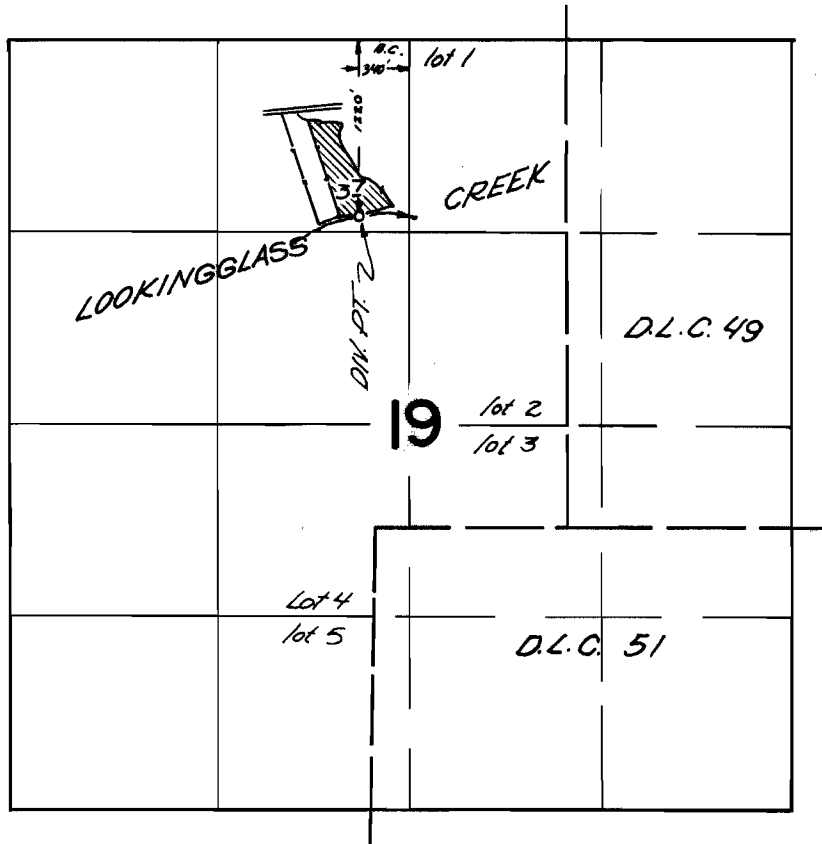

FINAL PROOF SURVEY UNDER

Application No. 39073 Permit No. 29094
IN NAME OF

IZOLA FRANCES MITCHELL

Surveyed April 25, 1967, by V. Garner