


# T.28S. R.6W. W.M.

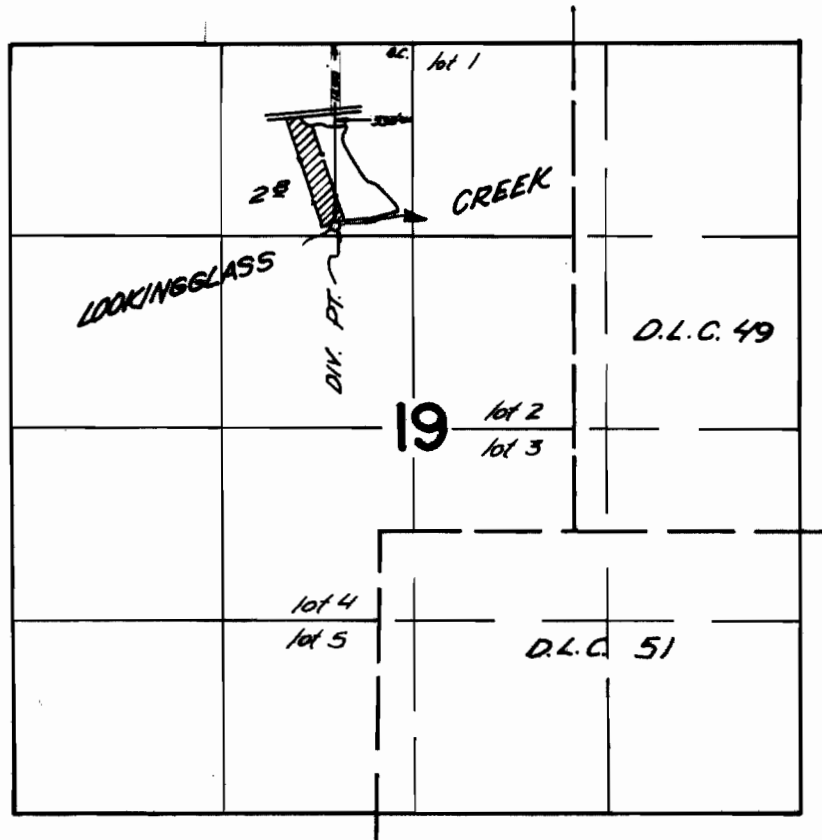

## FINAL PROOF SURVEY UNDER

Application No. 41391 Permit No. 30917  
IN NAME OF

IZOLA MITCHELL MORRISSE

Surveyed April 25 1967, by V. Garner