T.27S. R.7W. W.M.

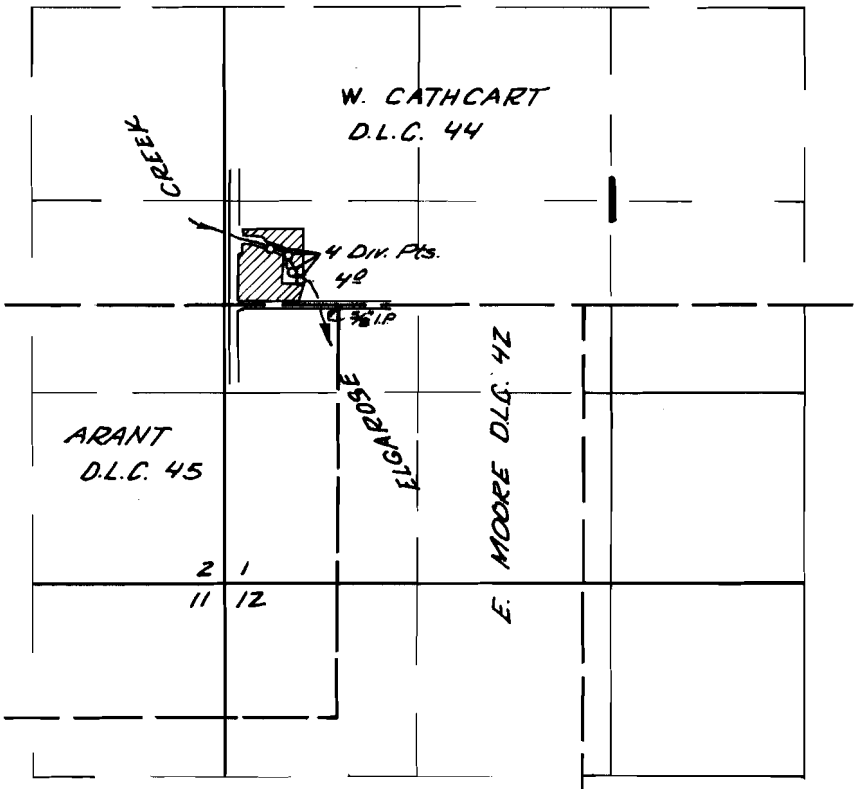

Div. pts. located 380 ft. N. and 450 ft. W.; 330 ft. N. and 340 ft. W.; 220 ft. N. and 310 ft. W.; 160 ft. N. and 250 ft. W. all from the N. W. corner E. Moore D.L.C. 47

FINAL PROOF SURVEY
UNDER

Application No. 40766 Permit No. 30384
IN NAME OF

GEORGE B. HANSEN

Surveyed April 28 19 67, by V. Garner

1967 - B