


T.32S.R.3E.W.M.

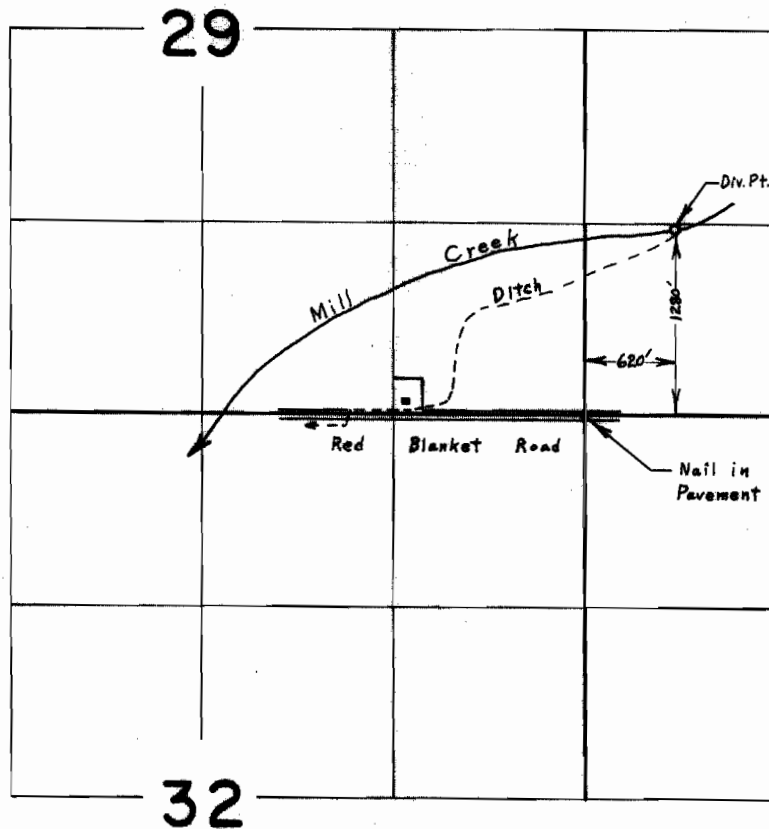

FINAL PROOF SURVEY
UNDER

Application No. 35095 Permit No. 27457
IN NAME OF

HARRY N. & ROSE MARIE HUNSLEY

Surveyed July 21, 1966, by L. E. Gould