


# T. 39S. R. 5W. W.M.

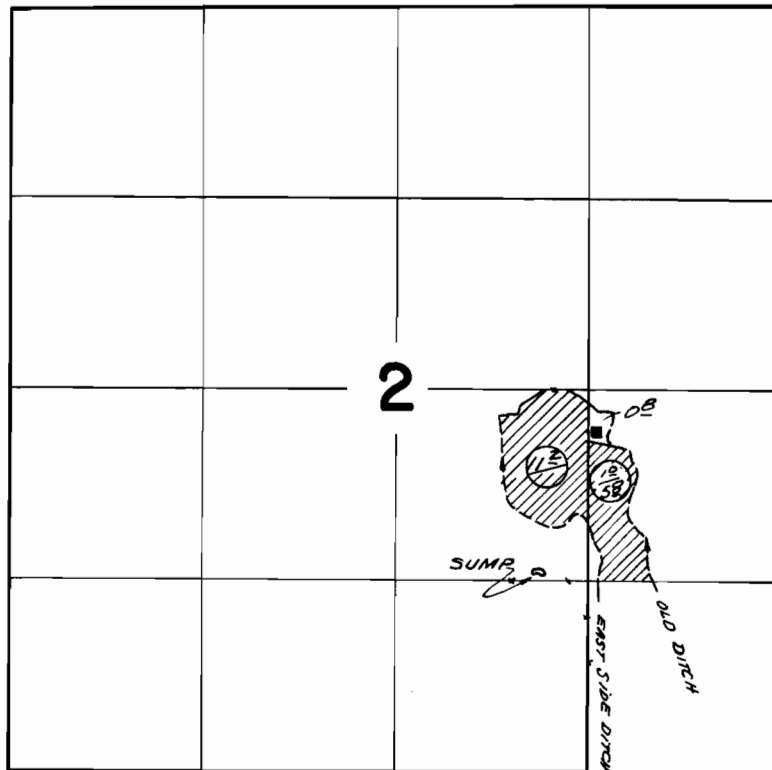

Sump located 70 ft. N. & 320 ft. W. from  
the SE cor. NW & SE  $\frac{1}{4}$  section 2

⊖ SUPPLEMENTAL  
PRIMARY

## FINAL PROOF SURVEY UNDER

Application No. G-2726... Permit No. G-2525.  
IN NAME OF

...NOAH J. and FAYE M. RIGEL...

Surveyed May 24, 1967, by V. Garner.....