


# T. 40S. R. 8W. W.M.

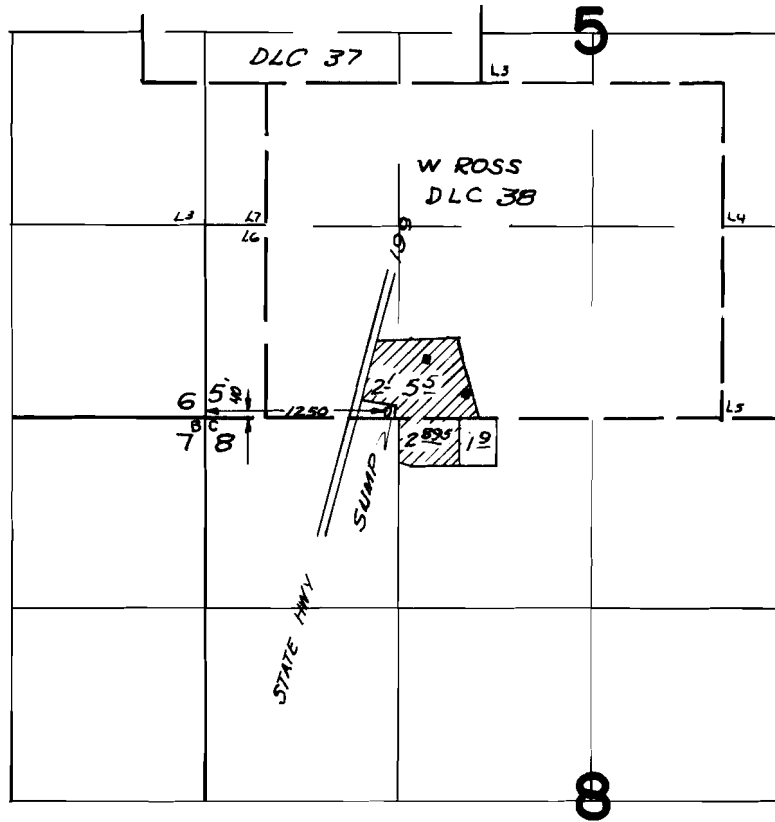

## FINAL PROOF SURVEY UNDER

Application No. G-2801 Permit No. G-2606  
IN NAME OF

ROBERT D. CHERRY

Surveyed May 18, 1967, by V. Garner