


T. 39 & 40 S. R. 7 & 8 W. W.M.

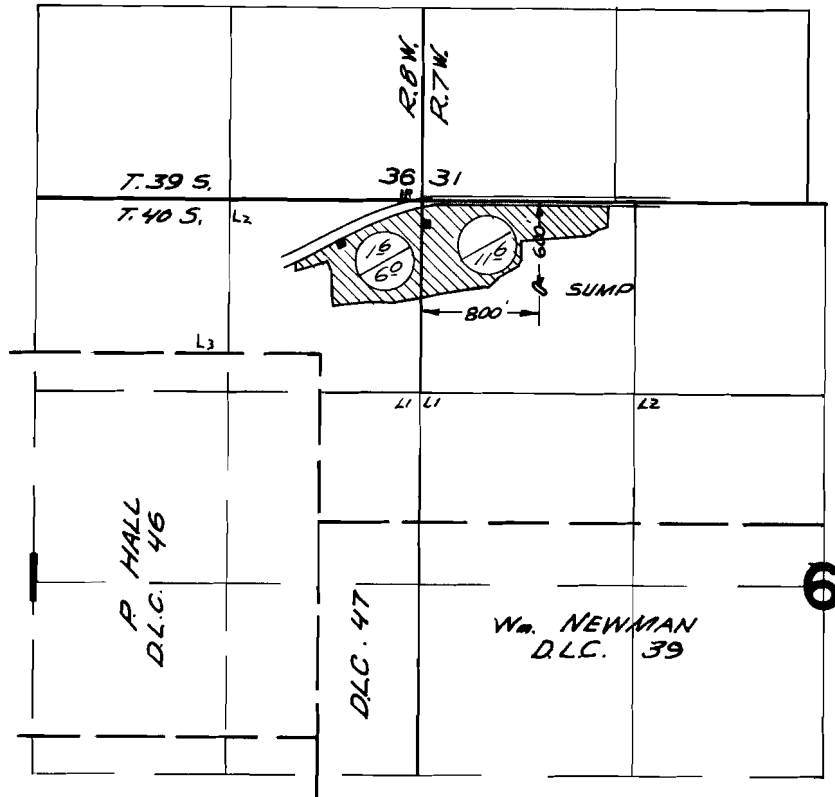

FINAL PROOF SURVEY UNDER

Application No. G-2799. Permit No. G-2722.
IN NAME OF

WARD WILSON

Surveyed May 20, 1967, by V. Garner