


T.36S. R.7W W.M.

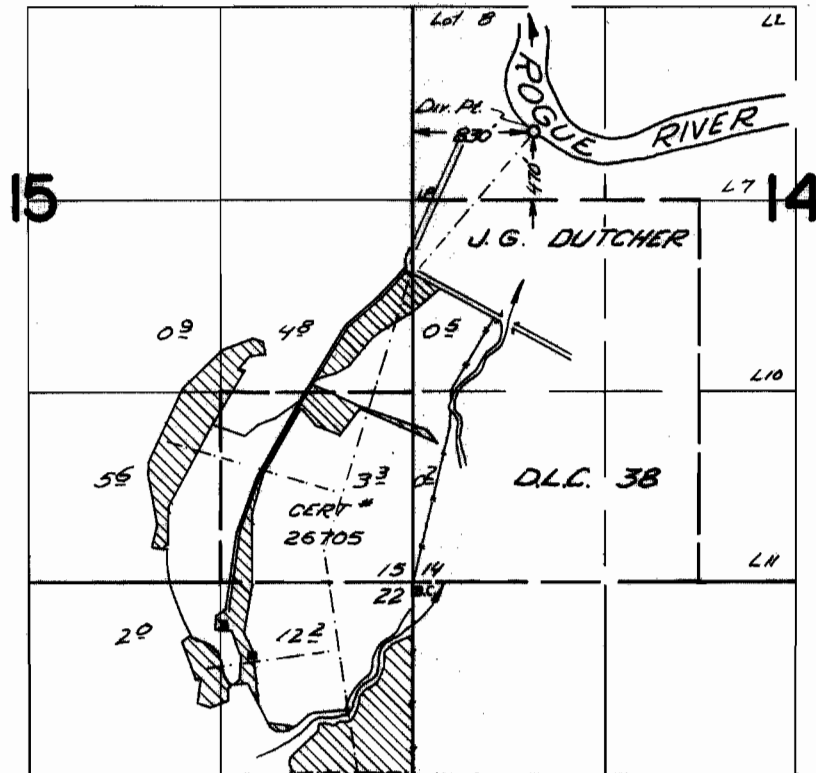

FINAL PROOF SURVEY UNDER

Application No. 34528 Permit No. 27115
IN NAME OF

PHILIP J. HUSSEY

Surveyed May 25, 1967, by V. Garner