
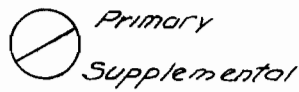


T.38 S. R.5W. W.M.

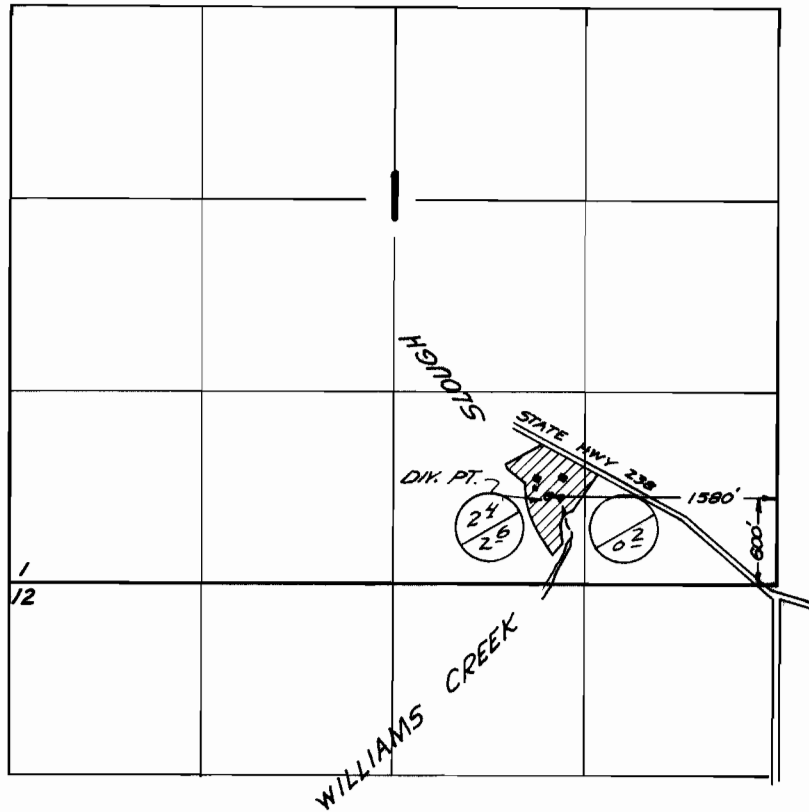

FINAL PROOF SURVEY UNDER

Application No. 38910 Permit No. 28963
IN NAME OF

CHESTER I. HERNEISEN

Surveyed May 24, 1967, by V. Garner