


T.39S. R.8W. W.M.

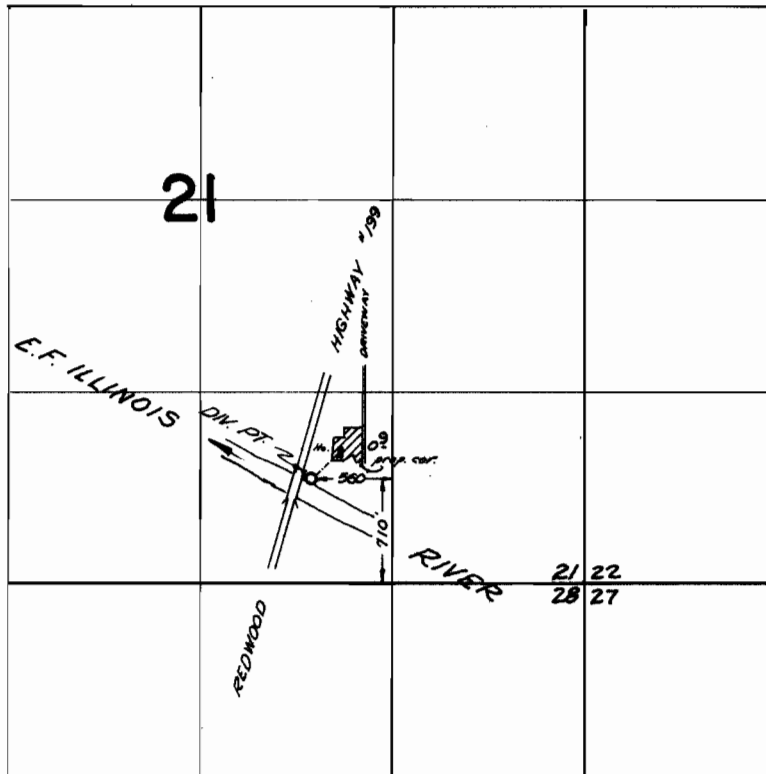

FINAL PROOF SURVEY UNDER

Application No. 38952 Permit No. 29338
IN NAME OF

Mrs. DORIS A. BOYD

Surveyed May 16 1967, by V. Garner