


T.35S. R.5W. W.M.

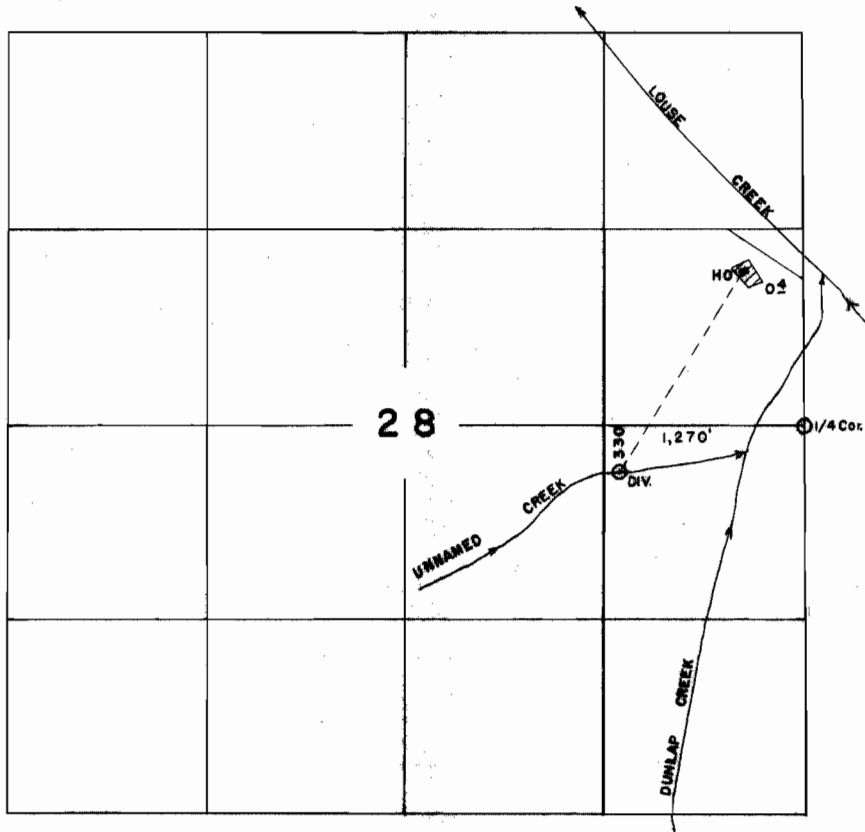

**FINAL PROOF SURVEY**  
UNDER

Application No. 39752... Permit No. 29566...  
IN NAME OF

.....EVERETT L. BURCH.....

Surveyed MAY 3... 1968, by R.B. STEIMER.....