


T. 37 S. R. 7 W. W.M.

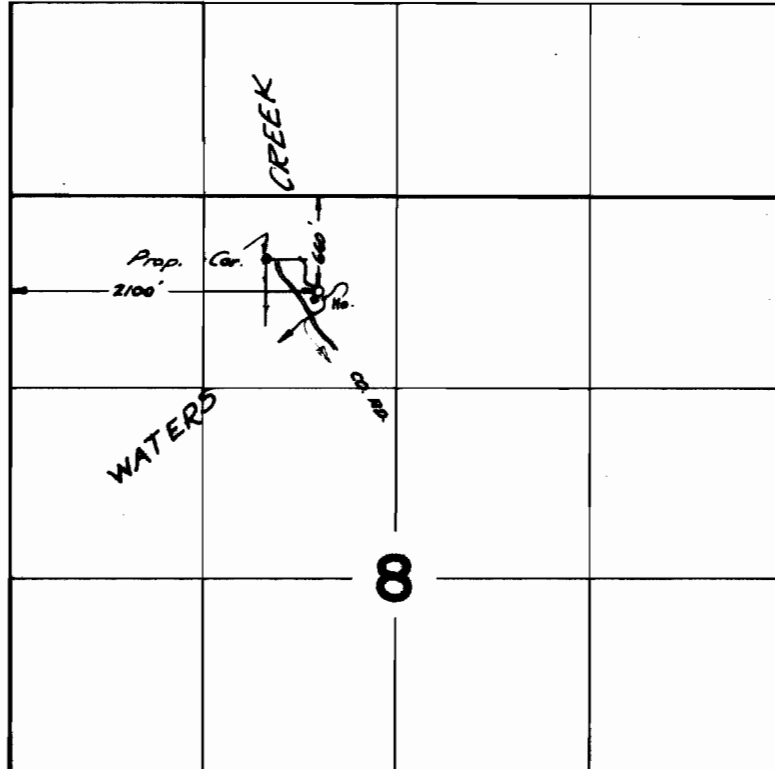

**FINAL PROOF SURVEY**  
UNDER

Application No. 41430... Permit No. 30942  
IN NAME OF

WILBUR M. MAYHEW

Surveyed May 22, 1967, by V. Gomer