


T.36S. R.11E. W.M.

Sprague River Wells

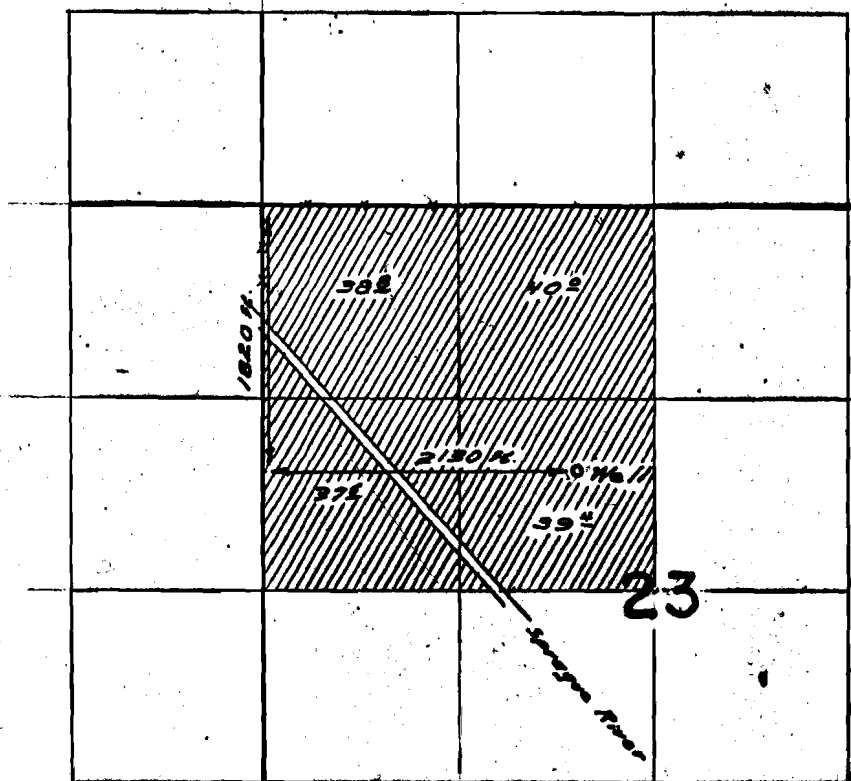

FINAL PROOF SURVEY UNDER

Application No. G-876 Permit No. G-773
IN NAME OF

HARRY E. MITCHELL

Surveyed Nov. 2 1966, by N. J. Ruppert