


T. 388, 39S. R. 11 1/2 E. W.M.

U-399
34894

Bude etc. : young Valley wells

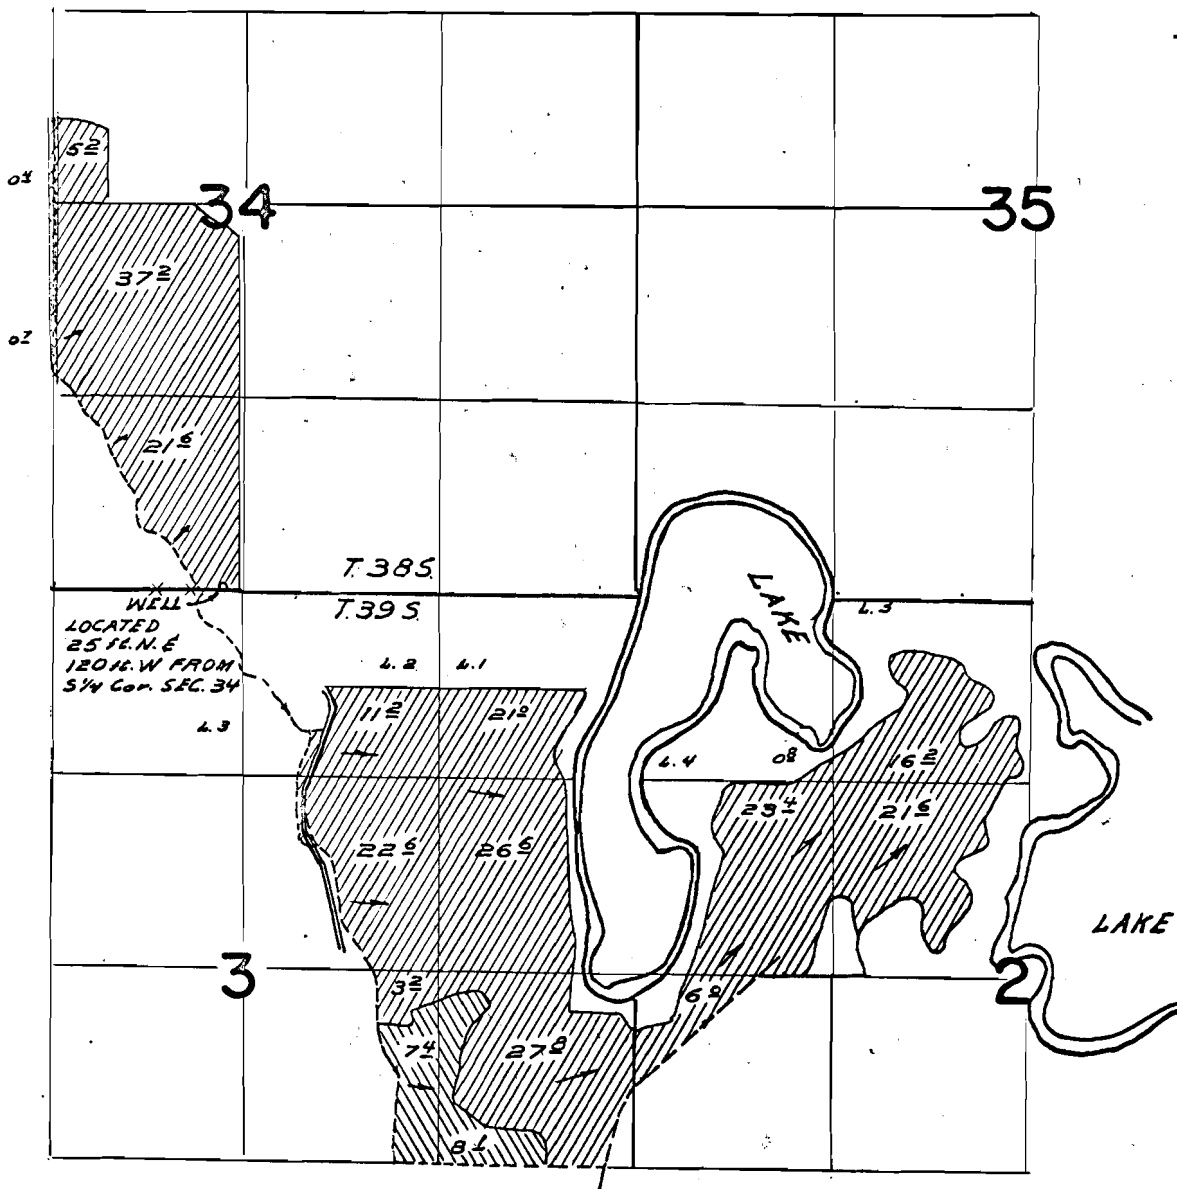

FINAL PROOF SURVEY
UNDER

Application No. U-424 Permit No. U-399
IN NAME OF

L. J. & ANNE S. HORTON

Surveyed Oct. 6th 1966, by W. J. Ruppert