



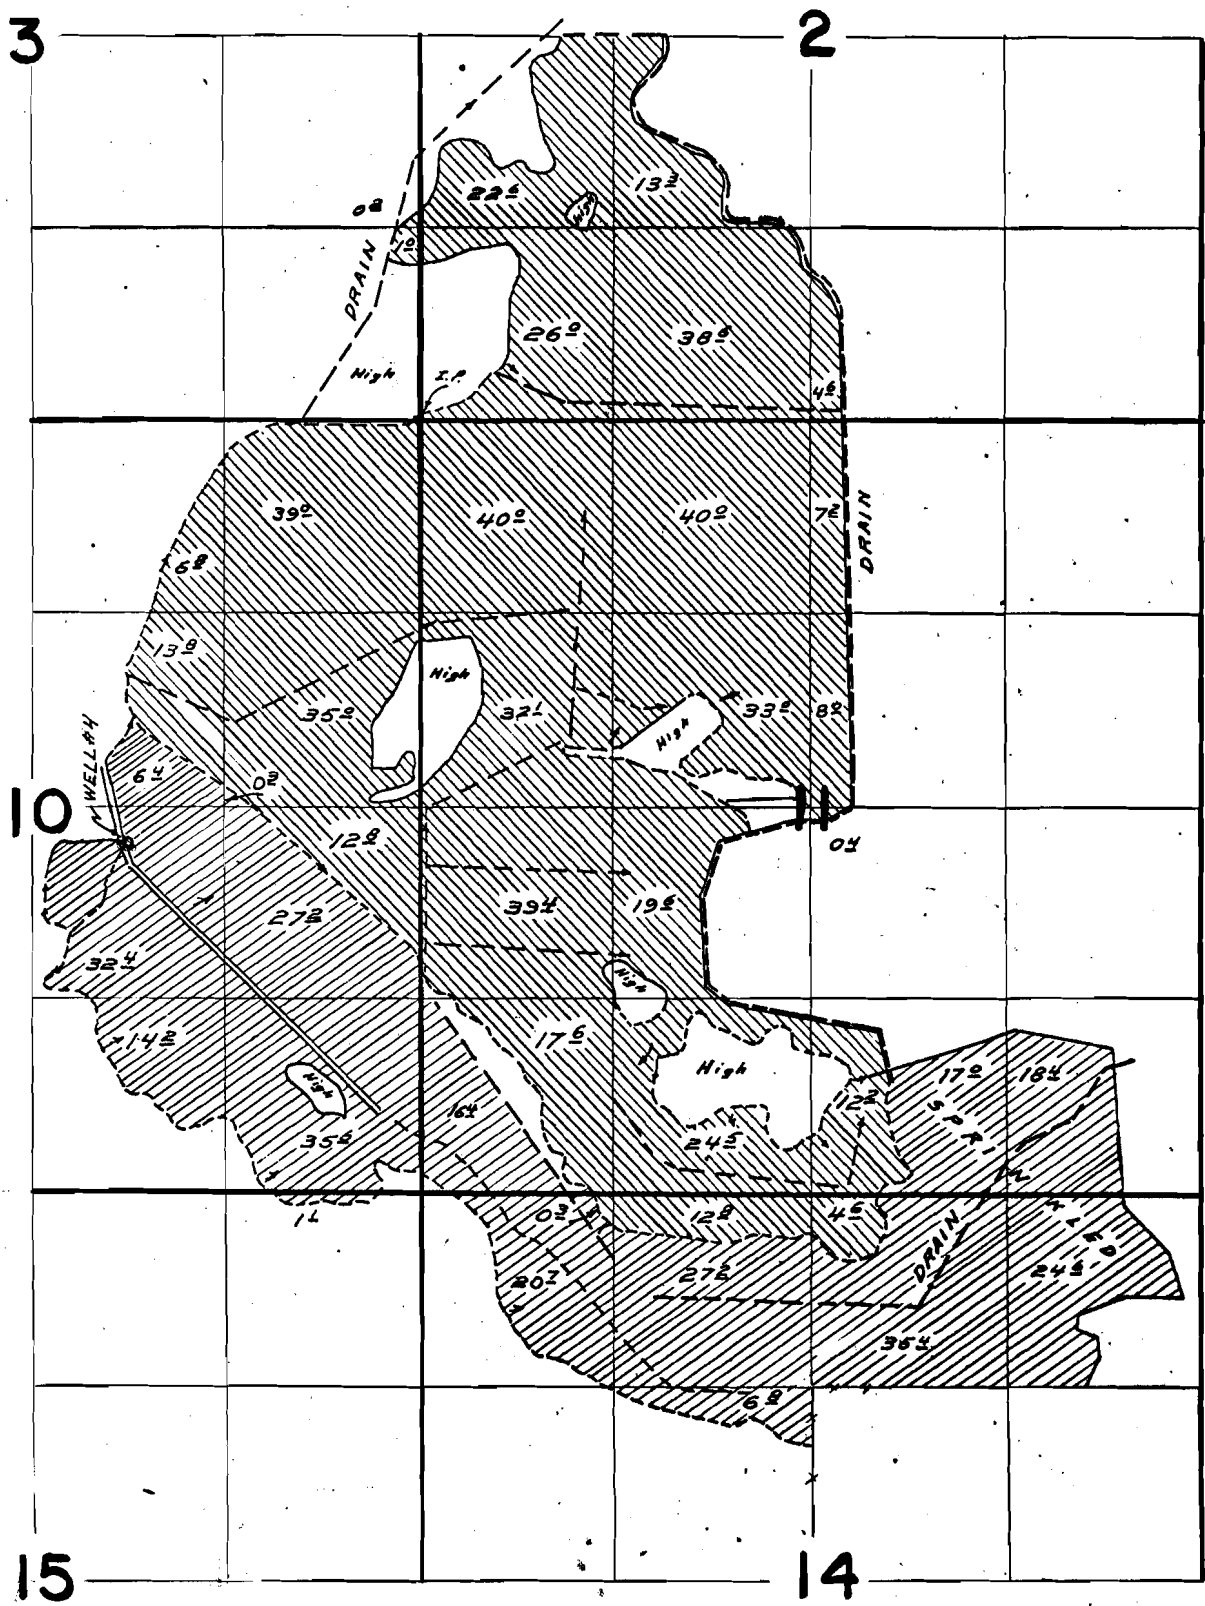

WELL LOCATED 2880 S. E. 1980 N.W. FROM N.E. COR. SEC. 10.

FINAL PROOF SURVEY

UNDER

Application No. G-1195 Permit No. 6-1002

IN NAME OF

L. J. & Ann S. Horton

Surveyed Oct 6 & 7 1966, by W. J. Ruppert