


# T.40S. R.IE. W.M.

Just River wells

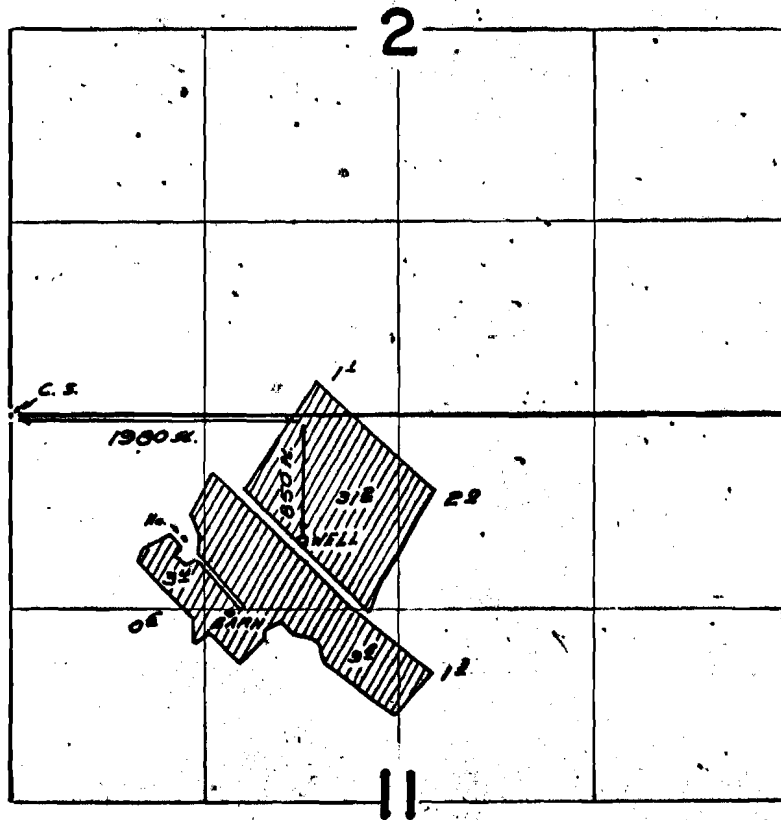

## FINAL PROOF SURVEY UNDER

Application No. G-2397 Permit No. G-2210  
IN NAME OF

A.W. Schaupp

Surveyed Nov. 3 1968, by H.A. Reppeck