


G-2371.
34897

T.39S.R.11E.W.M.

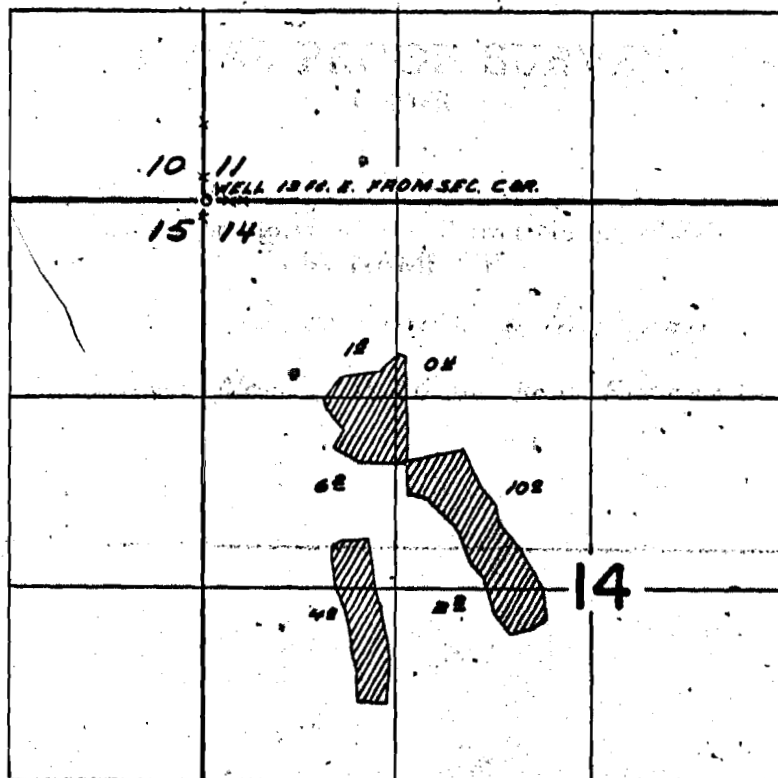

FINAL PROOF SURVEY
UNDER

Application No. G-2561 Permit No. G-2371
IN NAME OF

Ray C. or Linda L. McKay

Surveyed Nov. 1 1966, by W. J. Ruppert