


# T. 41S. R. 8E. W.M.

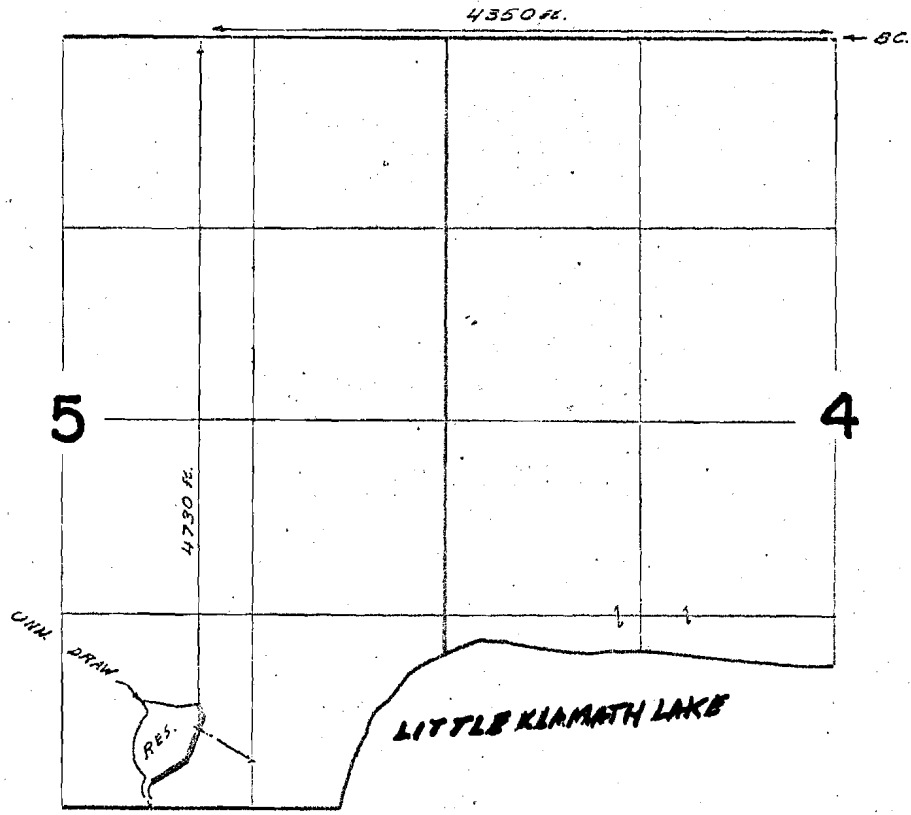

Klamath Riv. Meas.

## FINAL PROOF SURVEY UNDER

Application No. R-37283 Permit No. R-2787  
IN NAME OF

Winston H. & Louise Patterson

Surveyed Nov. 4 1966, by W. J. Ruppert