


T. 36 S. R. 12 E. W. M.

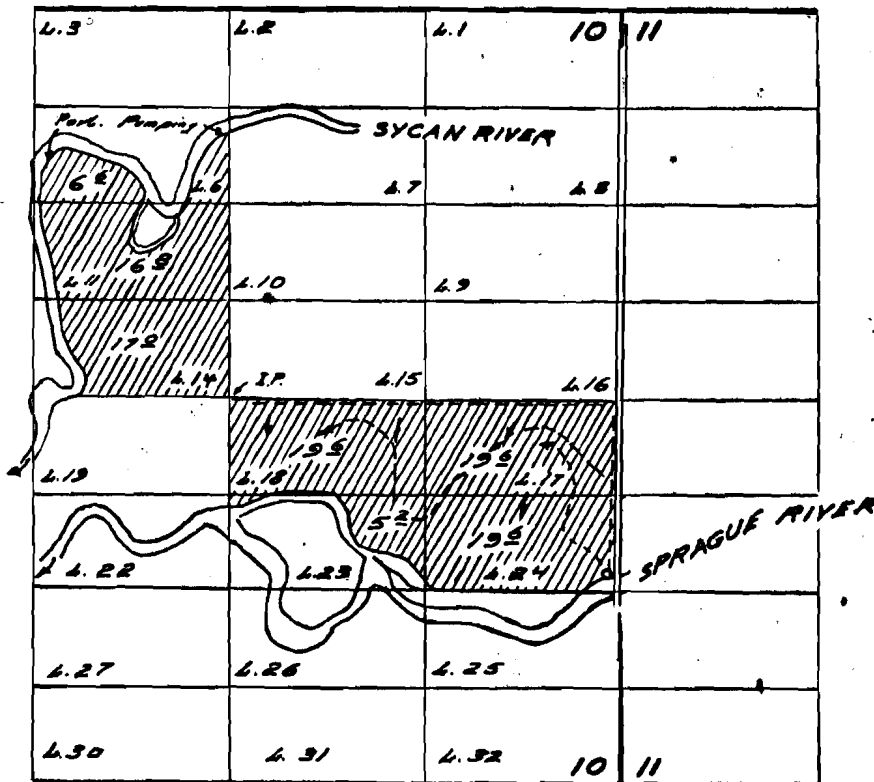

Div. P6 located 1170 ft. S. & 2560 ft. E.; and portable pumping from a point 1790 ft. N. & 50 ft. W. to a point 1600 ft. N. & 1820 ft. W. from Center Sec. 10

prague R.

FINAL PROOF SURVEY UNDER

Application No. 34274 Permit No. 26972
IN NAME OF

LEWIS B. & EDITH L. MATNEY

Surveyed Nov. 2, 1966, by N. L. Ruppert